


LABOR AND MATERIALS

Copper } Connection.....	\$.....
Lead }	\$.....
Curb { Cock Valve }	in. \$.....
{ T. S. & V. }
Service Box } Short 3 1/2 x 4 1/2 }	\$.....
Old returned } Long 4 1/2 x 5 1/2 }
{ Buffer Rdway }
Ft. in. { Copper } Pipe at	\$.....
{ Galv Iron }
{ Cast Iron }
Nipples..... in. at	\$.....
Bushings to in. at	\$.....
Red'g } Couplings to in. at	\$.....
Inc'g }
Union in. at	\$.....
Meter in. at	\$.....
Lead Joints at	\$.....
Leadite Joints at	\$.....
Hrs. Foreman at	\$.....
Hrs. Chauffeur at	\$.....
Hrs. Tapper at	\$.....
Hrs. Labor at	\$.....
Hrs. Labor at	\$.....
Hrs. Compressor at	\$.....
Compensation Ins.	\$.....
Trucking	\$.....
Builders Use of Water	\$.....
.....	\$.....
.....	\$.....
St. **74W**
 -Pl.
 Ave. No. **76**

Name of Owner
Tax ID # 302.19-28-15

Labor and Mat'l. Report **AUG 25 1939** 19

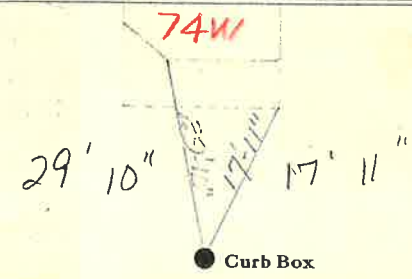

..... Main Elev. of Main at tap.....

Gate at ● ● Gate at

● Curb Box