

Labor and Materials


Copper } Connection.....	3	\$ 2.60
Lead } Connection.....	3	\$ 2.60
Curb } Cock Valve } in.....	3/4	\$ 2.30
	T.S. & V.	
Service Box } Short 3/4 x 1/2 }		\$ 1.40
Old returned } Long 1/2 x 3/4 }		
	Buff. or Rdway	
2.5 Ft. in. } Copper } Pipe at.....	3/4	\$ 6.63
	Galv. Iron }	
	Cast Iron	
Nipples..... in. at.....		\$
Bushings..... to..... in. at.....		\$
Red'g } Couplings..... to..... in. at.....		\$
Inc'g } Couplings..... to..... in. at.....		\$
Union..... in. at.....		\$
Meter..... in. at.....		\$
Lbs. Br. Stone at.....		\$
Lbs. Sand at.....		\$
Bags Cement at.....		\$
Paving Brick } Mack } at.....		\$
	Red	
	Asphalt	
Lead Joints at.....		\$
Leadite Joints at.....		\$
2 Hrs. Foreman at.....		\$ 1.25
4 Hrs. Common Labor at.....		\$ 1.63
Hrs. Common Labor at.....		\$
Hrs. Mason at.....		\$
Hrs. Mason's Helper at.....		\$
Hrs. Compressor at.....		\$
Compensation Ins.....		\$.08
Trucking.....		\$ 1.00
Builders' Use of Water Patch.....		\$ 5.10
Total \$		21.89

29-183 81W

Labor and Material Report

15 1927

63

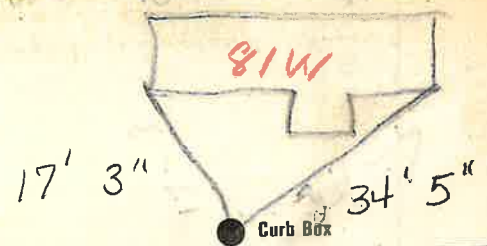

Liberty Ave
 Side
 Main Elev of Main at tap
 Gate at ● Gate at ●

● Curb Box

The tap comes in from Liberty Ave.

Tax ID# 302.19-25-14