


**Labor and Materials**

1	Copper	Connection	3	\$ 2.70
1	Curb	Cock Valve	2	\$ 2.39
1	Service Box	Short 3/4x1/2	4	\$ 1.45
	Old returned	Long 1/2x5/8		
12	Ft. 3/4"	Copper Pipe at		\$ 3.24
	Nipples	in. at		\$
	Bushings	to in. at		\$
	Red'g Inc'g	Couplings to in. at		\$
	Union	in. at		\$
	Meter	in. at		\$
	Lbs. Br. Stone	at		\$
	Lbs. Sand	at		\$
	Bags Cement	at		\$
	Paving Brick	Mack Red Asphalt at		\$
	Lead Joints	at		\$
	Leadite Joints	at		\$
4	Hrs. Foreman	at		\$ 2.50
16	Hrs. Common Labor	at		\$ 7.20
	Hrs. Common Labor	at		\$
	Hrs. Mason	at		\$
	Hrs. Mason's Helper	at		\$
2	Hrs. Compressor	at		\$ 3.00
	Compensation Ins.			\$ .39
	Trucking			\$ 1.-
	Builders' Use of Water	Patch		\$ 6.-
Total				\$ 28.87

30-42 15-E  
 Labor and Material Report May 16 1930

4 noted above

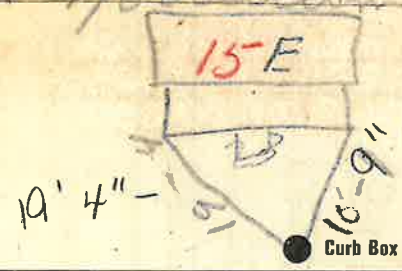

6 Main Eley of Main at tap 5.2  
 Gate at ● Gate at ●

● Curb Box

Old tap disconnected.

TAX ID# 302.20-16-8