

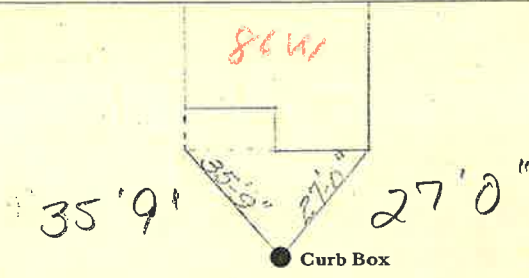
LABOR AND MATERIALS

Copper	}	Connection.....	\$.....	
Lead					
Curb	{	Cock Valve T. S. & V. } in.	\$.....	
Service Box Old returned					
	}	Short 3½x4½	\$.....	
		Long 4½x5½			
		Buffer Rdway			
Ft. in.	}	Copper	Pipe at.....	\$.....	
		Galv Iron			
		Cast Iron			
Nipples.....	in. at			\$.....	
Bushings.....	to.....	in. at		\$.....	
Red'g Inc'g	}	Couplings.....	to.....	in. at	\$.....
Union.....		in. at		\$.....	
Meter.....	in. at		\$.....		
Lead Joints at			\$.....		
Leadite Joints at			\$.....		
Hrs. Foreman at			\$.....		
Hrs. Chauffeur at			\$.....		
Hrs. Tapper at			\$.....		
Hrs. Labor at			\$.....		
Hrs. Labor at			\$.....		
Hrs. Compressor at			\$.....		
Compensation Ins.			\$.....		
Trucking			\$.....		
Builders Use of Water			\$.....		
			\$.....		
			\$.....		
St. 86W
 Pl.
 Ave. No. 88

Name of Owner
Tax ID # 302.19-27-4.2

Labor and Mat'l. Report AUG 25 1939 19

86W


..... Main
Elev. of Main at tap.....

Gate at ●
● Gate at

● Curb Box

AUG 25 1939

Labor and Materials

1	Copper } Connection	3/4	\$ 3 20
	Lead } Cock	3/4	
1	Curb } Valve	3/4	\$ 1 00
		P. S. & V.	
1	Service Box } Short 3 1/2 x 4 1/2		
	Old returned } Long 4 1/2 x 5 1/2		\$ 1 30
		Buff. or Rdway	
29	Ft. 3/4 in. } Copper		
		Galv. Iron	
		Cast Iron	\$ 6 38
	Nipples	in. at	\$
	Bushings	to in. at	\$
	Red'g } Couplings	to in. at	\$
	Inc'g }		
	Union	in. at	\$
	Meter	in. at	\$
	Lbs. Br. Stone at		\$
	Lbs. Sand at		\$
	Bags Cement at		\$
	Paving Brick } Mack		
		Red	
		Asphalt	\$
	Lead Joints at		\$
	Leadite Joints at		\$
7	Hrs. Foreman at		\$ 1 25
14	Hrs. Common Labor at		\$ 20 3
	Hrs. Common Labor at		\$
	Hrs. Mason at		\$
	Hrs. Mason's Helper at		\$
	Hrs. Compressor at		\$
	Compensation Ins.		\$ 09
	Trucking		\$ 100
	Builders' Use of Water		\$

Total \$ 16 25

86W
Labor and Material Report

Sept 1929

88 Notre Dame

No Measurement

New House 86W

● Curb Box

6 Main

Elev. of Main at tap 4 10

Gate at ●

● Gate at

● Curb Box