


LABOR AND MATERIALS

1	Copper Lead	Connection	3/4"	\$
1	Curb	Cock Valve Pr. S. & V.	3/4 in. (MARK II) (ORISEAL)	\$
1	Service box Old returned	Short 3 1/2 x 4 1/2 Long 4 1/2 x 5 1/2 Buff or Rdway	4' x 5'	\$
11	Ft. 3/4 in.	Copper Pipe at		\$
	Nipples	in. at		\$
	Bushings	to in. at		\$
	Red'g Inc'g	Coupl'gs to in. at		\$
	Union	in. at		\$
	Meter	in. at		\$
	Lead Joints at			\$
	Compound Joints at			\$
	Maintenance Foreman			\$
	Hrs. Water Maint. Man-1 at			\$
	Hrs. Water Maint. Man-2 at			\$
	Hrs. Garage Foreman at			\$
	Hrs. Labor at			\$
	Hrs. Compressor at			\$
	Compensation Ins. at \$	per C		\$
	Trucking			\$
	Pav't Patch			\$
	Tap made by ROSNEY			
	O'head	Nov-1-1974		\$

St. W. Notre Dame Pt. Ave. No. 87

Name of Owner Samuel Friedman

Labor and Mat'l. Report Nov. 1 1974

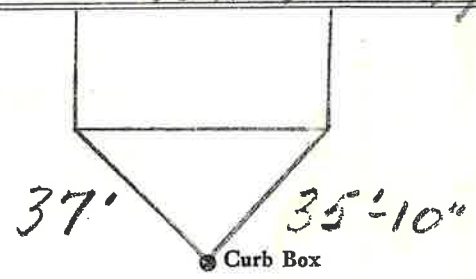

6" Main Elev. of Main at tap 5'  
 Gate at • Gate at •

• Curb Box  
 TAX ID # 302.19-24-5