


LABOR AND MATERIALS

1	Copper	} Connection $\frac{3}{4}$ "	\$
	Lead		
1	Curb	} $\frac{3}{4}$ in. O-r seal	\$
	Cock Valve T.S. & V.		
1	Service box	} Short $3\frac{1}{2}$ x $4\frac{1}{2}$	\$
	Old returned		Long $4\frac{1}{2}$ x $5\frac{1}{2}$
		Buff or Rdway	\$
29 Ft.	$\frac{3}{4}$ in.	} Copper	\$
			G.I.
		G.I.	\$
		Pipe at	\$
	Nipples	in. at	\$
	Bushings	to in. at	\$
	Red'g	} Coupl'gs. to in. at	\$
	Inc'g		
	Union	in. at	\$
	Meter	in. at	\$
	Lead Joints at		\$
	Compound Joints at		\$
	Maintenance Foreman		\$
	Hrs. Water Maint. Man-1 at		\$
	Hrs. Water Maint. Man-2 at		\$
	Hrs. Garage Foreman at		\$
	Hrs. Labor at		\$
	Hrs. Compressor at		\$
	Compensation Ins. at \$ per C		\$
	Trucking		\$
	Pav't Patch		\$
	Tap by Gifford + C.		\$
	11 - 26 - 63.		\$
	O'head		\$
			\$

St. W. Notre Dame Ave. No. 88

Name of Owner Manning Cohen.

Labor and Mat'l. Report Nov. 26 1963

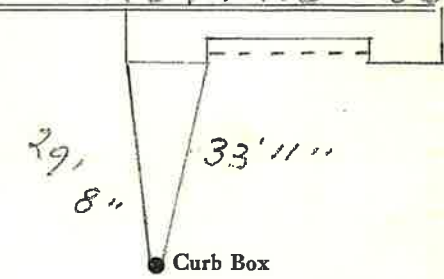

6" Main Elev. of Main at tap 4 to 5'

Gate at • Gate at

• Curb Box

Tax ID # 302.19-27-5.1