


**Labor and Materials**

1	Copper Lead } Connection	$\frac{3}{4}$	\$ 320
1	Curb { Cock Valve } T.S. & V.	in. $\frac{3}{4}$	\$ 1.80
1	Service Box } Short 3 1/2 x 4 1/2 } Old returned } Long 4 1/2 x 5 1/2 } Buff. or Redway }		\$ 1.30
9	Ft. in. } Copper Galv. Iron } Pipe at. } Cast Iron }	$\frac{3}{4}$	\$ 198
	Nipples	in. at.	\$
	Bushings	to in. at.	\$
	Red'g Inc'g } Couplings	to in. at.	\$
	Union	in. at.	\$
	Meter	in. at.	\$
	Lbs. Br. Stone	at.	\$
	Lbs. Sand	at.	\$
	Bags Cement	at.	\$
	Paving Brick } Mack Red Asphalt }	at.	\$
	Lead Joints	at.	\$
	Leadite Joints	at.	\$
3	Hrs. Foreman	62.5	\$ 187
	Hrs. Common Labor		\$
7	Hrs. Common Labor	40.5 1/2	\$ 284
	Hrs. Mason	at.	\$
	Hrs. Mason's Helper	at.	\$
	Hrs. Compressor	at.	\$
	Compensation Ins.		\$ .08
1/2	Trucking		\$ 1.00
1/2	Builders' Use of Water		\$
Total			\$ 1327

27-11 96W

Labor and Material Report Apr 7 1927

96 Water Main at

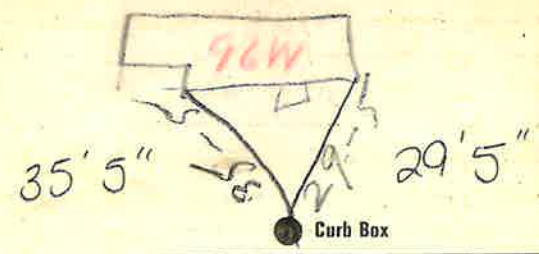

6 Main Elev. of Main at tap 4 1/2  
 Gate at ● Gate at ●

● Curb Box

New House  
 Curro

Tax ID # 302.19.26.4