


LABOR AND MATERIALS

1	Copper	} Connection	3/4"	\$	_____	
	Lead					
1	Curb	} Cock Valve	3/4 in.	\$	_____	
						T.S. & V.
1	Service box	} Short 3 1/2 x 4 1/2	}	\$	_____	
	Old returned					Long 4 1/2 x 5 1/2
						Buff or Rdway
10 Ft.	3/4 in.	} Copper	} Pipe at	\$	_____	
						G.I.
						C.I.
	Nipples	in. at	\$	_____		
	Bushings	to in. at	\$	_____		
	Red'g } Inc'g }	Coupl'gs	to in. at	\$	_____	
	Union	in. at	\$	_____		
	Meter	in. at	\$	_____		
	Lead Joints at		\$	_____		
	Compound Joints at		\$	_____		
	Maintenance Foreman		\$	_____		
	Hrs. Water Maint. Man-1 at		\$	_____		
	Hrs. Water Maint. Man-2 at		\$	_____		
	Hrs. Garage Foreman at		\$	_____		
	Hrs. Labor at		\$	_____		
	Hrs. Compressor at		\$	_____		
	Compensation Ins. at \$	per C	\$	_____		
	Trucking		\$	_____		
	Pav't Patch		\$	_____		
	Tap by Beecher & Co.		\$	_____		
	April 28, 1978		\$	_____		
	O'head		\$	_____		
			\$	_____		

St. Pl. Ave. No. 100
W. Notre Dame

Name of Owner
Joseph Moncoir

Labor and Mat'l. Report April 28 1978

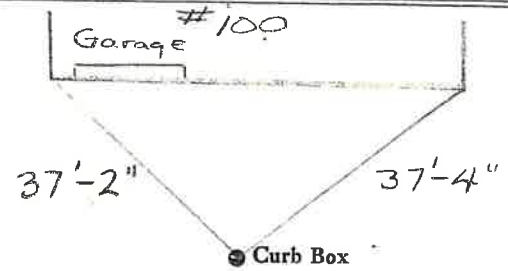

6" Main Elev. of Main at tap 5'
 Gate at • Gate at •

• Curb Box

Tax ID # 302.19-26-5