


LABOR AND MATERIALS

_____	Copper	} Connection _____	\$ _____
_____	Lead		
_____	Curb	} _____ in.	\$ _____
	Cock		
	Valve T.S. & V.		
_____	Service box	{ Short 3-1/2 x 4-1/2 }	\$ _____
_____	Old returned		{ Long 4-1/2 x 5-1/2 }
_____	Ft. _____ in.	{ Copper G.I. C.I. }	Pipe at _____ \$ _____
_____	Nipples _____ in.		at _____ \$ _____
_____	Bushings _____ to _____ in.		at _____ \$ _____
_____	Red'g		
_____	Inc'g		
_____	Union _____ in.	at _____	\$ _____
_____	Meter _____ in.	at _____	\$ _____
_____			\$ _____
_____	Compound Joints at _____		\$ _____
_____	Maintenance Foreman _____		\$ _____
_____	Hrs. Water Maint. Man - 1 at _____		\$ _____
_____	Hrs. Water Maint. Man - 2 at _____		\$ _____
_____	Hrs. Garage Foreman _____ at _____		\$ _____
_____	Hrs. Labor _____ at _____		\$ _____
_____	Hrs. Compressor at _____		\$ _____
_____			\$ _____
_____	Trucking _____		\$ _____
_____	Pav't Patch _____		\$ _____
_____			\$ _____
_____			\$ _____
_____			\$ _____
_____			\$ _____

St. _____
Pl. _____
Ave. No. _____

Name of Owner
16 E NOTRE DAME

Labor and Mat'l. Report 19

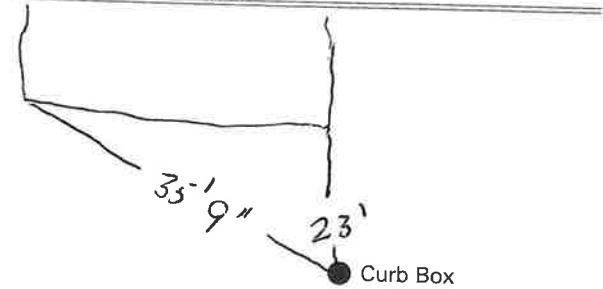

21' Main
Elev. of Main at tap _____

Gate at ● Gate at ●

● Curb Box

Tax ID # 302.20-12-19