

Oct. 24, 1925

17
 Labor and Material Report *Pat 24* 1925

20 Notre Dame
 House 17

17'0" → 17'0" ← 7'3"

Curb Box

6" Main Elev. of Main at tap 5.00

Gate at ● ● Gate at

● Curb Box

John Miller


EAST NORTDAM St.
 Pl. Ave. No. 17

Name of Owner

NEW ↘

Labor and Mat'l. Report 19

4/20/10

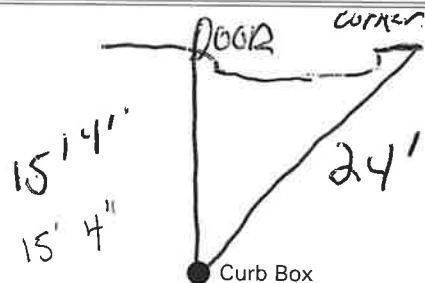

4" Main

Elev. of Main at tap

4'

Gate at ●

● Gate at

● Curb Box

OUTSIDE CLEAN OUT
 6" SEWER MAIN 20'
 FROM CURB 8" MAIN ALL
 NEW

Labor and Materials

1 Lead Connection \$
 1 Curb Cock \$
 1 Service Box { Short 3 1/2 x 4 1/2 }
 Old returned { Long 4 1/2 x 6 1/2 } \$
 14 Ft. 3/4 in. ^{1/2} Pipe at \$
 Nipples in. at \$
 Bushings to in. at \$
 Red'g Coup. to in. at \$
 Inc'g Coup. to in. at \$
 Union in. at \$
 Meter in. at \$
 Cu. Yds. Br. Stone at \$
 Cu. Yds. Sand at \$
 Bags Cement at \$
 Paving Brick { Mack }
 { Red }
 { Asphalt } at \$
 1 1/2 Hrs. Foreman at \$
 13 Hrs. Common Labor at \$
 Hrs. Mason at \$
 4 Hrs. ^{Compressor} at \$
 Hrs. at \$
 4 1/2 Builders' Use of Water \$
 at \$
 Truck 100 at \$
 Payment at \$
 at \$
 Total \$.....

LABOR AND MATERIALS

3/4 ^{Copper} } Connection \$
 Lead }
 Curb } Cock }
 Valve } in. \$
 T.S. & V. }
 Service box { Short 3-1/2 x 4-1/2 }
 Old returned { Long 4-1/2 x 5-1/2 } \$
 13' Ft. in. ^{Copper} } Pipe at \$
 G.I. }
 C.I. }
 Nipples in. at \$
 Bushings to in. at \$
 Red'g
 Inc'g
 Union in. at \$
 Meter in. at \$
 \$
 Compound Joints at \$
 Maintenance Foreman \$
 Hrs. Water Maint. Man - 1 at \$
 Hrs. Water Maint. Man - 2 at \$
 Hrs. Garage Foreman at \$
 Hrs. Labor at \$
 Hrs. Compressor at \$
 \$
 Trucking \$
 Pav't Patch \$
 \$
 \$
