


LABOR AND MATERIALS

| | | | | |
|----|-------------------------------------|--|----------|---------------------|
| 1 | Copper | } Connection | 3/4" | \$ 3.08 |
| | Lead | | | |
| 1 | Curb | } Cock Valve T.S. & V. | 3/4 in. | \$ 3.89 |
| 1 | Service box | | | |
| | Old returned | | | |
| | | } Short 3 1/2 x 4 1/2 Long 4 1/2 x 5 1/2 Buff or Rdway | | \$ 4.32 |
| 22 | | | | |
| 24 | 24 Ft. | } Copper G.I. C.I. | 3/4 in. | Pipe at 45 \$ 10.80 |
| | | | | |
| 1 | 3" Male Adapter | | | \$.73 |
| | Nipples | | | |
| | Bushings | | | |
| | Red'g } Coupl'gs | | | |
| | In'g } | | | |
| | Union | | | |
| | Meter | | | |
| | Lead Joints at | | | |
| | Compound Joints at | | | |
| | Maintenance Foreman | | | |
| | Hrs. Water Maint. Man-1 at | | | |
| | Hrs. Water Maint. Man-2 at | | | |
| 4 | Hrs. Garage Foreman | | at 20.33 | \$ 8.13 |
| 20 | Hrs. Labor | | at 1.30 | \$ 26.00 |
| | Hrs. Compressor at | | | |
| | Compensation Ins. at \$ 5.686 per C | | | \$ 1.94 |
| | Trucking | | | \$ 1.50 |
| | Pav't Patch | | | \$ 14.40 |
| | Tap by Wadleigh | | | \$ |
| | Labeau 6-14-56 | | | \$ |
| | O'head | | | \$ |
| | | | | \$ 74.79 |

St. Numan
 Pl. 5
 Ave. No. 5

Name of Owner John Hogan

Labor and Mat'l. Report JUNE 14 1956

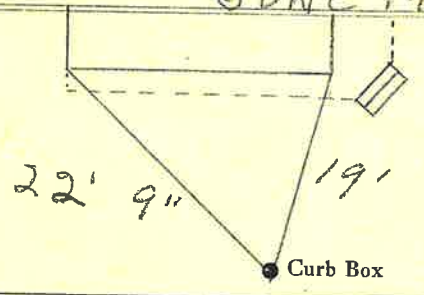

Elev. of Main at tap 5'
 Gate at • • Gate at

• Curb Box
 TAX 10th 303.17-88