


Labor and Materials

1	Copper } Connection ^{4"} ^{3/4"}	\$ 1.50
1	Lead } Cock	
1	Curb { Valve } 3/4" in	\$ 1.70
	{ T.S.&V. }	
1	Service Box { Short 3 1/2 x 4 1/2 }	\$ 1.44
	Old returned { Long 4 1/2 x 5 1/2 }	
	{ Buff. or Rdway }	
22	Ft. 3/4" in { Copper } Pipe at	\$ 4.56
	{ Galv. Iron }	
	{ Cast Iron }	
	Nipples in. at	\$
	Bushings to in. at	\$
	Red'g } Couplings to in. at	\$
	Inc'g }	
	Union in. at	\$
	Meter in. at	\$
	Lbs. Br. Stone at	\$
	Lbs. Sand at	\$
	Bags Cement at	\$
	Paving Brick { Mack } at	\$
	{ Red }	
	{ Asphalt }	
	Lead Joints at	\$
	Leadite Joints at	\$
4	Hrs. Foreman at ^{F&C} ^{6 1/2 hr}	\$ 2.50
8	Hrs. Common Labor at ^{SP}	\$ 4.-
8	Hrs. Common Labor at ^{AS}	\$ 3.60
	Hrs. Mason at	\$
	Hrs. Masons Helper at	\$
	Hrs. Compressor at	\$
	Compensation Ins	\$ 0.36
	Trucking	\$ 1.-
	Builders Use of Water ^{Prov. Pkch.}	\$ 5.-
	Total	\$ 25.66

41 34

Labor and Material Report July 1964

Old tap at 7th main

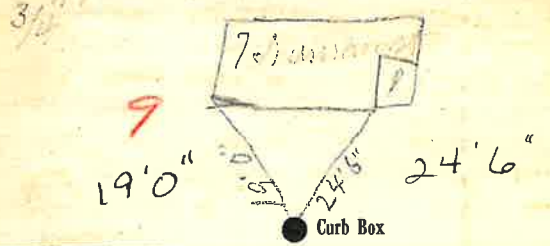

6" - 1964

Main Elev. of Main at tap 6.10

Gate at ● Gate at ●

Old tap cut off at main

Tax ID# 303.17-8-6

[Handwritten signature]