

LABOR AND MATERIALS

1	Copper	{ Connection	3/4	\$	2.87
	Lead				
1	Curb	{ Cock Valve	3/4 in.	\$	3.62
		{ T. S. & V.			
12	Service box	{ Short 3 1/2 x 4 1/2		\$	4.68
	Old returned	{ Long 4 1/2 x 5 1/2			
		{ Buff or Rdway			
<del>10</del>	Ft.	{ Copper	3/4 in.	\$	3.20
		{ G. I.	Pipe at 32		
		{ C. I.			
	Nipples	in. at		\$	
	Bushings	to in. at		\$	
1	Red's	{ Coupl'gs	3/4 to 3/4 in. at	\$	
	Jac's		1964 Cop to Cop.		
	Union	in. at		\$	
	Meter	in. at		\$	
	Lead Joints at			\$	
	Compound Joints at			\$	
	Hrs. Water Maint. Man-1 at			\$	
3	Hrs. Water Maint. Man-2 at	1.02		\$	3.06
18	Hrs. Labor	at 91		\$	16.38
	Hrs. Labor	at		\$	
	Hrs. Compressor at			\$	
	Compensation Ins. at \$	per C.		\$	.42
	Trucking			\$	2.00
	Pav't Patch			\$	10.25
	<i>Taylor Maguire</i>			\$	
	O'head			\$	
				\$	46.48

127

St.

Pl.

Ave. No.


10

Name of Owner

*Bishop*

Labor and Mat'l. Report

*Nov 16 1949*

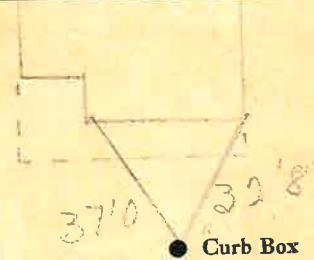

*6"-1964.*

*4" Gal*

Main

Elev. of

Main at tap

*3-1*

Gate at ●

● Gate at

● Curb Box

Tax ID# 303.17-1-24