

LABOR AND MATERIALS

| | | | | |
|----|-----------------------|--|-------------------|----------|
| 1 | Copper | Connection | $\frac{3}{4}$ | \$ 1.35 |
| 1 | Curb | Cock Valve T. S. & V. | $\frac{3}{4}$ in. | \$ 1.88 |
| 1 | Service Box | Short $3\frac{1}{2} \times 4\frac{1}{2}$ | | \$ 1.82 |
| 20 | Old returned | Long $4\frac{1}{2} \times 5\frac{1}{2}$ | | |
| 23 | Ft. | $\frac{3}{4}$ in. | | \$ 4.60 |
| | | Copper Galv. Iron Cast Iron | Pipe at | |
| | Nipples | in. at | | \$ |
| | Bushings | to in. at | | \$ |
| | Red'g Inc'g | Couplings to in. at | | \$ |
| | Union | in. at | | \$ |
| | Meter | in. at | | \$ |
| | Lead Joints | at | | \$ |
| | Leadite Joints | at | | \$ |
| | Hrs. Foreman | at | | \$ |
| 14 | Hrs. Chauffeur | at | .6834 | \$ 9.62 |
| | Hrs. Tapper | at | | \$ |
| 14 | Hrs. Labor | at | .55 | \$ 7.70 |
| | Hrs. Labor | at | | \$ |
| 1 | Hrs. Compressor | at | .92 | \$ 92 |
| | Compensation Ins. | | | \$.53 |
| | Trucking | | | \$ 1.00 |
| | Builders Use of Water | Patch | | \$ 5.00 |
| | Tapped by Marinski | | | \$ |
| | | | | \$ |
| | | | | \$ |
| | | | | \$ 34.42 |

33 1942

St. 11
 Pl. 9
 Ave. No. 9


Numan

Name of Owner

Davis

Labor and Mat'l. Report

July 22, 1942

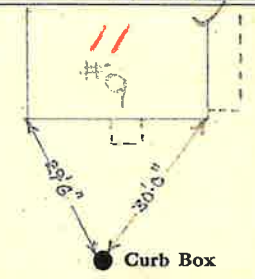

6" CI 1965

Main Elev. of Main at tap. 6

Gate at ● Gate at ●

Tax ID# 303.17-85

Top on Traver St

REVERSE CURB STOP -
 "ON" POSITION IS OFF