

Labor and Materials

1	Copper	Connection	3/4"	\$	3.20
	Lead				
1	Curb	Cock Valve	3/4" in.	\$	1.00
		T.S. & V.			
1	Service Box	Short 3 1/2 x 4 1/2		\$	1.30
	Old returned	Long 4 1/2 x 5 1/2			
		Buff. or Rdway			
1	Ft. 3/4"	Copper	Pipe at	\$	1.98
		Galv. Iron			
		Cast Iron			
	Nipples	in. at		\$	
1	Bushings	3/4" to 1/2" in. at	CoP2	\$	1.20
1	Red'g Inc'g	Couplings	3/4" to 3/4" in. at	\$	
			CoP 1964		
	Union	in. at		\$	
	Meter	in. at		\$	
	Lbs. Br. Stone	at		\$	
	Lbs. Sand	at		\$	
	Bags Cement	at		\$	
	Paving Brick	Mack Red Asphalt	at	\$	
	Lead Joints	at		\$	
	Leadite Joints	at		\$	
9	Hrs. Foreman	at	6 1/2	\$	5.63
1	Hrs. Common Labor	at	10	\$	1.00
9	Hrs. Common Labor	at	10 1/8	\$	2.66
	Hrs. Mason	at		\$	
	Hrs. Mason's Helper	at		\$	
	Hrs. Compressor	at		\$	
	Compensation Ins.			\$	2.30
	Trucking			\$	10.00
	Builders' Use of Water			\$	


Total 18.62

27-100 12

Labor and Material Report

19

the tap at 10 in main at

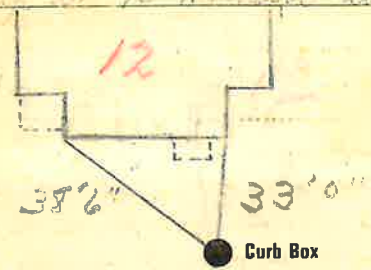

6" - 1964
C.I.

Elev. of Main at tap 5'

Gate at ● Gate at ●

● Curb Box

Old tap shut off.

Tax ID #

Tax ID # 303.17-1-25