


Labor and Materials

1	Lead Connection	\$
1	Curb Cock	\$
1	Service Box (Short 3 1/2 x 4 1/2 Old returned Long 4 1/2 x 5 1/2 Buffalo Curb	\$
3	Ft. 1 in. G.I. Pipe at	\$
	Nipples..... in. at	\$
	Bushings..... to..... in. at	\$
	Red'g Coup..... to..... in. at	\$
	Inc'g Coup..... to..... in. at	\$
	Union..... in. at	\$
	Meter..... in. at	\$
	Cu. Yds. Br. Stone at	\$
	Cu. Yds. Sand at	\$
	Bags Cement at	\$
	Paving Brick { Mack Red Asphalt } at	\$
5	Hrs. Foreman at	\$
10	Hrs. Common Labor at	\$
	Hrs. Mason at	\$
	Hrs..... at	\$
	Hrs..... at	\$
	Builders' Use of Water	\$
	Trucks 100	\$
 at	\$
 at	\$
 at	\$
 at	\$
	Total	\$	76.69

15 Labor and Material Report Dec 26 1923

1" tap at 19 Oak St

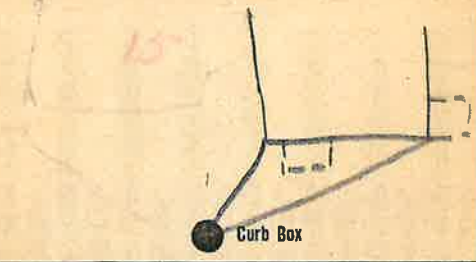

New - Curb box to main - 5/87
6" Main Elev. of Main at tap

Gate at ● Gate at ●

● Curb Box

Tax 10th 303.17 20-7