

LABOR AND MATERIALS

1	Copper	} Connection $\frac{3}{4}$ "	\$	
	Lead			
1	Curb	} Cock Valve } $\frac{3}{4}$ in.	\$	
			} T.S. & V. }	
1	Service box	} Short $3\frac{1}{2} \times 4\frac{1}{2}$ Long $4\frac{1}{2} \times 5\frac{1}{2}$ Buff or Rdway }	\$	
	Old returned			
5	Ft. $\frac{3}{4}$ in.	} Copper G.I. G.I. }	Pipe at \$	
	Nipples		in. at \$	
	Bushings		to in. at \$	
	Red'g } Inc'g }	Coupl'gs	to in. at \$	
	Union	in. at \$		
	Meter	in. at \$		
	Lead Joints	at \$		
	Compound Joints	at \$		
	Maintenance Foreman	\$		
	Hrs. Water Maint. Man-1	at \$		
	Hrs. Water Maint. Man-2	at \$		
	Hrs. Garage Foreman	at \$		
	Hrs. Labor	at \$		
	Hrs. Compressor	at \$		
	Compensation Ins. at \$	per C \$		
	Trucking	\$		
	Pay't Patch	\$		
	Tap by Seymour	\$ & Co.		
		\$		
		5-26-71. \$		
	O'head	\$		
		\$		

Oak


St. Pl. Ave. No. 17

Name of Owner

Staves.

Labor and Mat'l. Report

May 26 1971

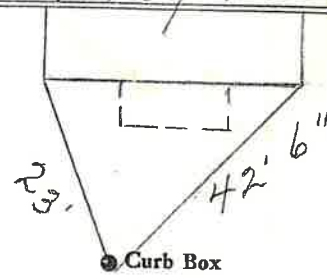

6" Main

Elev. of Main at tap

Gate at ●

● Gate at

Tax ID # 303.17-20-8

● Curb Box

New - curb box to main - 5/87