

Labor and Materials


Copper	}	Connection.....	\$					
Lead									
Curb	}	Cock Valve T. S. & V. } in	\$				
Service Box						}	Short 3½ x 4½ Long 4½ x 5½	\$
Old returned									
Ft. in.	}	Copper Galv Iron Cast Iron	} Pipe at	\$				
Nipples						in. at	\$	
Bushings						to	in. at	\$
Red'g Inc'g	}	Conplings	to	in. at	\$				
Union						in. at	\$	
Meter	in. at	\$					
Lead Joints at	\$					
Leadite Joints at	\$					
Hrs. Foreman at	\$					
Hrs. Chauffeur at	\$					
Hrs. Tapper at	\$					
Hrs. Labor at	\$					
Hrs. Labor at	\$					
Hrs. Compressor at	\$					
Compensation Ins.	\$					
Trucking	\$					
Builders Use of Water	\$					
.....	\$					
.....	\$					
St. 6
Pl. 12-14
Ave. No.

Name of Owner

Labor and Mat'l. Report

19

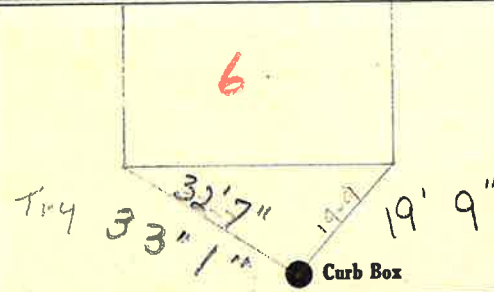

6" Main

Elev. of Main at tap

Gate at ●

● Gate at

● Curb Box

6-8
TAX ID# 303.17-19-1