

### Labor and Materials


Copper Lead	Connection	3	\$ 3.20
Curb	Cock Valve T. S. & V.	34	\$ 1.00
Service Box Old returned	Short 4x4 1/2 Long 4x5 1/2	4	\$ 1.40
4 1/2 Ft. 3/4 in.	Copper Galvanized Cast Iron	Pipe at 3/4	\$ 1.76
Nipples	in. at		\$
Bushings	to in. at		\$
Red'g Inc'g	Couplings to in. at		\$
Union	in. at		\$
Meter	in. at		\$
Lbs. Br. Stone	at		\$
Lbs. Sand	at		\$
Bags Cement	at		\$
Paving Brick	Mack Red Asphalt at		\$
Lead Joints	at		\$
Leadite Joints	at		\$
7 Hrs. Foreman	at		\$ 2.50
10 Hrs. Common Labor	at		\$ 4.06
Hrs. Common Labor	at		\$
Hrs. Mason	at		\$
Hrs. Mason's Helper	at		\$
1 Hrs. Compressor	at		\$ 1.50
Compensation Ins			\$ 1.17
Trucking			\$ 1.00
Builders' Use of Water			\$

Total \$ 16.59

2897 7  
Labor and Material Report

Aug 7 1928

13 Out at

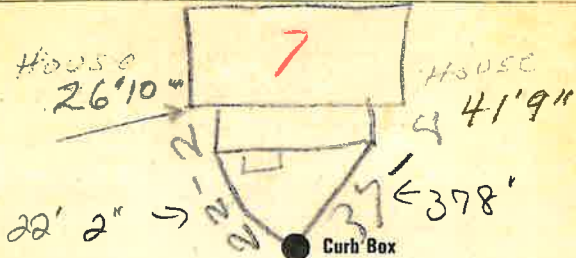

6" Main

Elev of Main at tap

Gate at

Gate at

Tax ID# 303.17-20-12

Curb Box

Old tap shut off

New - curb Box to Main - 5/87

10-28-00

Dug up + repaired sewer service -

7'-8' deep