

LABOR AND MATERIALS

Copper	} Connection _____	\$ _____	
Lead			
Curb	} Cock Valve } _____ in. _____ \$ _____	\$ _____	
			} T. S. & V. }
Service box	} Short 3½ x 4½ Long 4½ x 5½ Buff or Rdway }	\$ _____	
Old returned			
²⁸ / ₂₅ Ft. ^{3/4} in.	} Copper G.I. C.I. }	Pipe at _____ \$ _____	
Nipples _____ in.	at _____	\$ _____	
Bushings _____ to _____ in.	at _____	\$ _____	
Red'g } Inc'g }	} Coupl'gs _____ to _____ in. at _____ \$ _____	\$ _____	
Union _____ in.			at _____
Meter _____ in.	at _____	\$ _____	
Lead Joints at _____		\$ _____	
Compound Joints at _____		\$ _____	
Maintenance Foreman _____		\$ _____	
Hrs. Water Maint. Man-1 at _____		\$ _____	
Hrs. Water Maint. Man-2 at _____		\$ _____	
Hrs. Garage Foreman _____ at _____		\$ _____	
Hrs. Labor _____ at _____		\$ _____	
Hrs. Compressor at _____		\$ _____	
Compensation Ins. at \$ _____ per C		\$ _____	
Trucking _____		\$ _____	
Pav't Patch _____		\$ _____	
		\$ _____	
		\$ _____	
O'head _____		\$ _____	
		\$ _____	


St. _____
Pt. _____
Ave. No. 10

Name of Owner _____

C. Finley

Labor and Mat'l. Report _____

10-4 1986

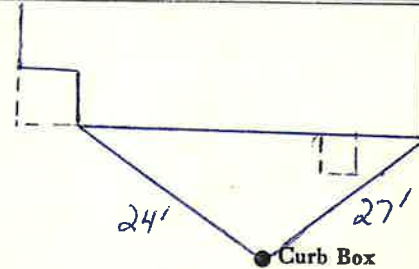

6" Main

Elev. of
Main at tap _____

Gate at • _____

• Gate at _____

• Curb Box

TAX ID # 303.17-19-2