


Labor and Materials

1	Copper	Connection	\$	3.20
	Lead			
1	Curb	Cock Valve in	\$	1.00
		T. S. & V.		
1	Service Box	Short 3 1/2 x 4 1/2	\$	1.40
	Old returned	Long 4 1/2 x 5 1/2		
		Bull. or Rdway		
14	Ft.	Copper in	\$	3.08
		Galv. Iron		
		Cast Iron		
	Nipples in. at	\$	
	Bushings to in. at	\$	
	Red'g	Couplings to in. at	\$	
	Inc'g			
	Union in. at	\$	
	Meter in. at	\$	
	Lbs. Br. Stone	at	\$	
	Lbs. Sand	at	\$	
	Bags Cement	at	\$	
	Paving Brick	Mack at	\$	
		Red		
		Asphalt		
	Lead Joints	at	\$	
	Leadite Joints	at	\$	
	Hrs. Foreman	at	\$	
13	Hrs. Common Labor	at	\$	5.28
	Hrs. Common Labor	at	\$	
	Hrs. Mason	at	\$	
	Hrs. Mason's Helper	at	\$	
	Hrs. Compressor	at	\$	
	Compensation Ins.	\$	1.14
1	Trucking	\$	1.00
	Builders' Use of Water	\$	
				Total	\$ 15.10

Labor and Material Report

60
19 27

3/4 tap 60' ...

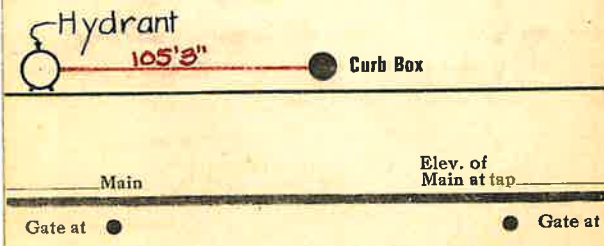

● Curb Box