

Labor and Materials

1	Copper	} Connection.....	\$ 3.20	
	Lead			
1	Curb	{ Cock Valve }	\$ 1.00	
				{ T. S. & V. }
1	Service Box	{ Short 3 1/2 x 4 1/2 Long 4 1/2 x 5 1/2 }	\$ 1.40	
	Old returned			{ Buff. or Rdway }
14	Ft. in.	{ Copper Galv. Iron } Pipe at	\$ 3.28	
		{ Cast Iron }		
	Nipples. in. at		\$.	
	Bushings. to	in. at	\$.	
	Red'g } Couplings	to	in. at	
	Inc'g }		\$.	
	Union. in. at		\$.	
	Meter. in. at		\$.	
	Lbs. Br. Stone at		\$.	
	Lbs. Sand at		\$.	
	Bags Cement at		\$.	
	Paving Brick	{ Mack Red } at	\$.	
				{ Asphalt }
	Lead Joints at		\$.	
	Leadite Joints at		\$.	
	Hrs. Foreman at		\$.	
13	Hrs. Common Labor at		\$ 5.28	
	Hrs. Common Labor at		\$.	
	Hrs. Mason at		\$.	
	Hrs. Mason's Helper at		\$.	
	Hrs. Compressor at		\$.	
	Compensation Ins.		\$.	
1	Trucking		\$ 1.00	
	Builders' Use of Water		\$.	
Total \$.			15.10	


Labor and Material Report

62

June 27

1927

3/4 top 62' burial at

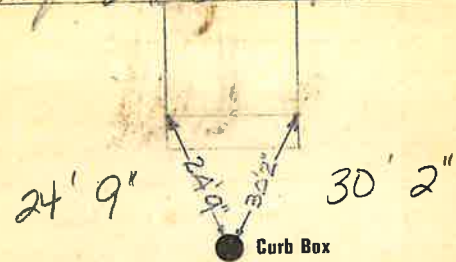

Main Elev. of
Main at tap

Gate at ● ● Gate at

● Curb Box