

**Labor and Materials**


1	Copper	Connection	2 1/2	\$	320
	Lead				
1	Curb	Cock Valve	3/4 in.	\$	100
		T. S. & V.			
1	Service Box	Short 3 1/2 x 4 1/2		\$	140
	Old returned	Long 4 1/2 x 5 1/2			
		Buff. or Rdway			
12	Ft. 3/4 in.	Copper Galv. Iron Cast Iron	Pipe at	\$	264
	Nipples	in. at		\$	
	Bushings	to in. at		\$	
	Red'g Inc'g	Couplings	to in. at	\$	
	Union	in. at		\$	
	Meter	in. at		\$	
	Lbs. Br. Stone	at		\$	
	Lbs. Sand	at		\$	
	Bags Cement	at		\$	
	Paving Brick	Mack Red Asphalt	at	\$	
	Lead Joints	at		\$	
	Leadite Joints	at		\$	
	Hrs. Foreman	at		\$	
13	Hrs. Common Labor	at		\$	528
	Hrs. Common Labor	at		\$	
	Hrs. Mason	at		\$	
	Hrs. Mason's Helper	at		\$	
	Hrs. Compressor	at		\$	
	Compensation Ins.			\$	14
1	Trucking			\$	100
	Builders' Use of Water			\$	
				Total	\$ 1466

**Labor and Material Report**

75

19 11

no 75 *Goldfield*

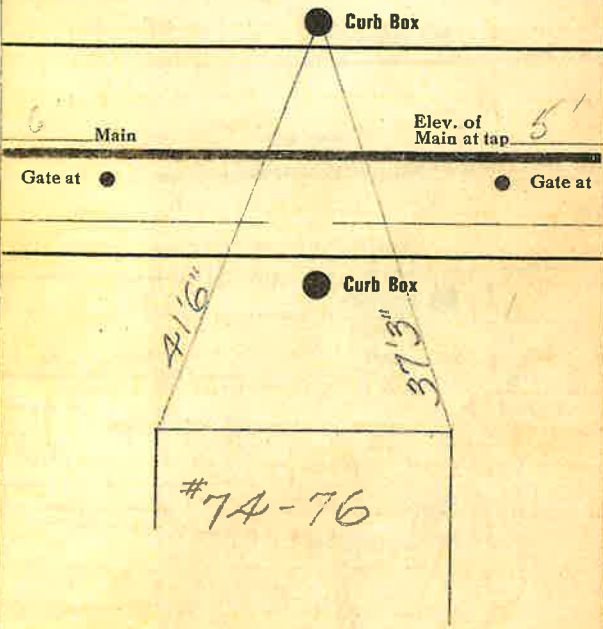

#74-76