

LABOR AND MATERIALS


1	Copper Lead	Connection	$\frac{3}{4}$ "	\$
1	Curb	Cock Valve T.S. & V.	$\frac{3}{4}$ " in. Oriseal	\$
1	Service box	Short $3\frac{1}{2}$ x $4\frac{1}{2}$		
	Old returned	Long $4\frac{1}{2}$ x $5\frac{1}{2}$		
		Buff or Rdway		\$
5	Ft. $\frac{3}{4}$ in.	Copper Pipe at		\$
		G.I.		
		C.I.		
	Nipples	in. at		\$
	Bushings	to in. at		\$
	Red'g			
	Inc'g	Coupl'gs to in. at		\$
	Union	in. at		\$
	Meter	in. at		\$
	Lead Joints	at		\$
	Compound Joints	at		\$
	Maintenance Foreman			\$
	Hrs. Water Maint. Man-1	at		\$
	Hrs. Water Maint. Man-2	at		\$
	Hrs. Garage Foreman	at		\$
	Hrs. Labor	at		\$
	Hrs. Compressor	at		\$
	Compensation Ins.	at \$ per C		\$
	Trucking			\$
	Pav't Patch			\$
	Tap by Gifford + Peterson			\$
		3-18-66.		\$
	O'head			\$

Oakland

St.   
 Pl.   
 Ave. No. 82-84

Name of Owner   
 Mike Toney

Labor and Mat'l. Report Mar. 18 1966.

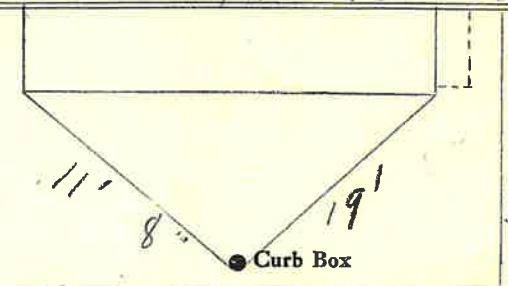

Fredella Ave.

6" Main Elev. of Main at tap 5 1/2'

Gate at • TAX ID# 310.5-4-15 • Gate at

Oakland Ave.

● Curb Box   
 Tap on Fredella Ave.

3/4" Renewal,   
 6" Water main under edge of walk.