

Labor and Materials


Copper } Connection.....	3	\$ 3.20
Lead }		
Curb { Cock Valve T. S. & V. }	1	\$ 1.00
Service Box { Short 3" x 4" Long 4" x 5" Rubber Redway }	1	\$ 1.20
1.6 Ft. in. { Copper Galv. Iron Cast Iron } Pipe at	3/4	\$ 3.96
Nipples..... in. at.....		\$
Bushings..... to..... in. at.....		\$
Red'g } Couplings..... to..... in. at.....		\$
Inc'g }		\$
Union..... in. at.....		\$
Meter..... in. at.....		\$
Lbs Br. Stone at.....		\$
Lbs. Sand at.....		\$
Bags Cement at.....		\$
Paving Brick { Mack Red Asphalt } at.....		\$
Lead Joints at.....		\$
Leadite Joints at.....	<i>None</i>	\$
6 Hrs. Foreman at.....	62.5	\$ 3.75
7 Hrs. Common Labor at.....	50	\$ 1.00
32 Hrs. Common Labor at.....	40 7/8	\$ 1.300
Hrs. Mason at.....		\$
Hrs. Mason's Helper at.....		\$
Hrs. Compressor at.....		\$
Compensation Ins.....	48	\$
Trucking	1.00	\$ 1.00
Builders' Use of Water.....		\$
Total		\$ 28.69

Labor and Material Report

39

1926

39 *Canal* *SK*

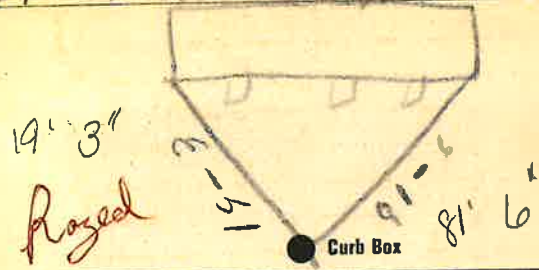

4 Main Elev. of Main at tap *6 1/2*
 Gate at ● Gate at ●

● Curb Box

Joe Fudella