

Labor and Materials


1	Copper	Lead	Connection	.....	\$	320
1	Curb	Cock Valve	T. S. & V.	..... in.	\$	1.00
1	Service Box	Short 3 1/2 x 4 1/2	Long 4 1/2 x 5 1/2	.....	\$	1.40
8	Ft.	Copper	Cast Iron	Pipe at	\$	1.76
	Nipples			..... in. at	\$	
	Bushings			..... to..... in. at	\$	
	Red'g	Inc'g	Couplings	..... to..... in. at	\$	
	Union			..... in. at	\$	
	Meter			..... in. at	\$	
	Lbs. Br. Stone			at	\$	
	Lbs. Sand			at	\$	
	Bags Cement			at	\$	
	Paving Brick	Mack	Red	Asphalt	at	\$
	Lead Joints			at	\$	
	Leadite Joints			at	\$	
	Hrs. Foreman			at	\$	
13	Hrs. Common Labor			at	\$	5.28
	Hrs. Common Labor			at	\$	
	Hrs. Mason			at	\$	
	Hrs. Mason's Helper			at	\$	
	Hrs. Compressor			at	\$	
	Compensation Ins.				\$	14
1	Trucking				\$	1.00
	Builders' Use of Water				\$	
	Total				\$	13.78

Labor and Material Report

56

June 27 1977

3/4 tap 56 *Oakland*

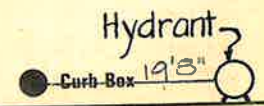

Main Elev. of Main at tap

Gate at ● ● Gate at

● Curb Box

curb box and rod. Removed 9-22-60.

curb cock under side walk.