

#44


Labor and Materials

Copper } Connection.....	3	\$ 1.48
Lead } .....	4	
Curb { Cock Valve } .....	3	\$ 1.79
{ U.S.&V. } .....	1	
Service Box { Short 3 1/2 x 4 1/2 } .....		\$ 1.30
Old returned { Long 4 1/2 x 5 1/2 } .....		
{ Buff. or Rdwce } .....		
24 Ft. .... in. { Copper Galv. Iron Cast Iron } Pipe at	3	\$ 4.32
Nipples .....		
in. at .....		
Bushings .....		
to .....		
in. at .....		
Red'g } Couplings..... to .....		
Inc'g } .....		
Union..... in. at .....		
Meter..... in. at .....		
Lbs. Br. Stone at .....		
Lbs. Sand at .....		
Bags Cement at .....		
Paving Brick { Mack Red Asphalt } at .....		
Lead Joints at .....		
Leadite Joints at .....		
10 Hrs. Foreman at .....		\$ 6.25
10 Hrs. Common Labor at .....		\$ 4.50
Hrs. Common Labor at .....		
Hrs. Mason at .....		
Hrs. Masons Helper at .....		
Hrs. Compressor at .....		
Compensation Ins .....		\$ 3.33
Trucking .....		\$ 1.00
Builders Use of Water Patch .....		\$ 2.50
Total		\$ 23.47

5-32-44 4

Labor and Material Report May 20 1933

2 Bodgen St

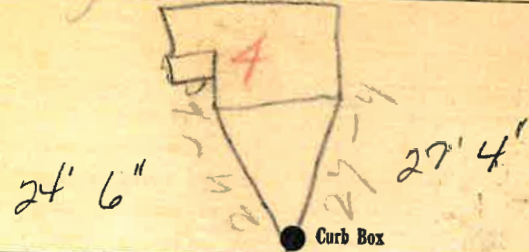

Main Elev. of Main at tap 6  
 Gate at ● Gate at ●

● Curb Box

old Tap to be chng up

PK 9/10