

LABOR AND MATERIALS

1	Copper Lead	Connection		\$ 1.23
1	Curb	Cock Valve T. S. & V.	3/4 in.	\$ 1.68
1	Service Box	Old returned	Short 3/2x4 1/2 Long 4 1/2x5 1/2 Buff. or Rdway	\$ 1.54
22	Ft. 3/4 in.		Copper Galv. Iron Cast Iron	Pipe at 17 \$ 3.74
	Nipples	in. at		\$
	Bushings	to in. at		\$
	Red'g Inc'g	Couplings	to in. at	\$
	Union	in. at		\$
	Meter	in. at		\$
	Lead Joints	at		\$
	Leadite Joints	at		\$
	Hrs. Foreman	at		\$
6	Hrs. Chauffeur	at 6 1/2		\$ 3.75
	Hrs. Tapper	at		\$
6	Hrs. Labor	at 45		\$ 2.70
	Hrs. Labor	at		\$
2	Hrs. Compressor	at 65		\$ 1.30
	Compensation Ins.			\$ 2.00
	Trucking			\$ 1.00
	Builders Use of Water			\$
	Tapkey Pen. & Co.			\$
	Patch (by Saver Dept)			\$ 2.50
				\$
				\$ 19.64

67 - - 1939


St. 14
Pt. Ave. No. 12

Osgood

Name of Owner

White

Labor and Mat'l. Report Sept. 1 1939

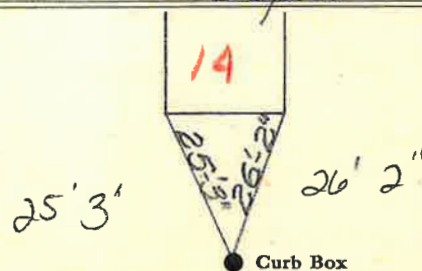

4" Main

Elev. of Main at tap 5'

Gate at ●

● Gate at

TAX ID # 302.16-4-6

● Curb Box

OUTSIDE CLEANOUT
1' LEFT OF CURB BOX

New House TH