

LABOR AND MATERIALS

1 Copper } Connection	$\frac{3}{4}$		\$ 1.35
1 Lead } } 1 Curb { Cock Valve T.S. & V. } 1 Service Box { Short $3\frac{1}{4} \times 4\frac{3}{4}$ Old returned { Long $4\frac{1}{2} \times 5\frac{1}{4}$ { Buffer Rdway } 23 Ft. $\frac{3}{4}$ in. { Copper Galv Iron } Pipe at	$\frac{3}{4}$ $\frac{3}{4}$	$\frac{3}{4}$ in.	\$ 4.14
Nipples	in. at		\$
Bushings	to	in. at	\$
Red'g Inc'g } Couplings	to	in. at	\$
Union	in. at		\$
Meter	in. at		\$
Lead Joints	at		\$
Leadite Joints	at		\$
Hrs. Foreman	at		\$ 94
1 1/2 Hrs. Chauffeur	at	$\frac{6}{2} \frac{1}{2}$	\$ 1.89
3 Hrs. Tapper	at		\$ 8.55
19 Hrs. Labor	at	45	\$
Hrs. Labor	at		\$
Hrs. Compressor	at		\$.35
Compensation Ins.			\$
Trucking			\$
Builders Use of Water	Before Paving		\$
Typ by Hessel			
			\$
			\$
			\$ 21.71

5 5 1941

St. 16
Pl. ---
Ave. No. 14


Adgen

Name of Owner

Eleanor Smith

Labor and Mat'l. Report

May 19 1931

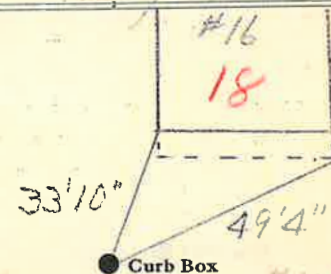

Elev. of
Main at tap 5

● Gate at

TAX ID # 302.16-4-7


LABOR AND MATERIALS

_____	Copper } Connection _____	\$ _____
_____	Lead } _____	\$ _____
_____	Curb } Cock _____	\$ _____
_____	Valve } _____ in.	\$ _____
_____	T.S. & V. } _____	\$ _____
_____	Service box { Short 3-1/2 x 4-1/2 } _____	\$ _____
_____	Old returned { Long 4-1/2 x 5-1/2 } _____	\$ _____
_____	Ft. _____ in. { Copper } Pipe at _____	\$ _____
_____	_____ { G.I. } _____	\$ _____
_____	_____ { C.I. } _____	\$ _____
_____	Nipples _____ in. at _____	\$ _____
_____	Bushings _____ to _____ in. at _____	\$ _____
_____	Red'g _____	\$ _____
_____	Inc'g _____	\$ _____
_____	Union _____ in. at _____	\$ _____
_____	Meter _____ in. at _____	\$ _____
_____	_____	\$ _____
_____	Compound Joints at _____	\$ _____
_____	Maintenance Foreman _____	\$ _____
_____	Hrs. Water Maint. Man - 1 at _____	\$ _____
_____	Hrs. Water Maint. Man - 2 at _____	\$ _____
_____	Hrs. Garage Foreman _____ at _____	\$ _____
_____	Hrs. Labor _____ at _____	\$ _____
_____	Hrs. Compressor at _____	\$ _____
_____	_____	\$ _____
_____	Trucking _____	\$ _____
_____	Pav't Patch _____	\$ _____
_____	_____	\$ _____
_____	_____	\$ _____
16 St. Ogden
Pl. Ave. No. 16

Name of Owner _____

Labor and Mat'l. Report ~~10~~ 2013

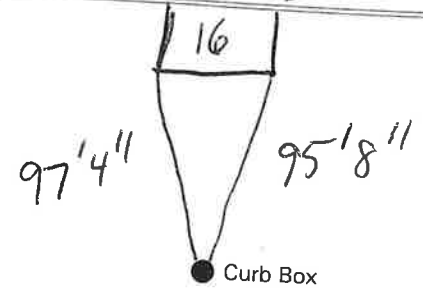

_____ Main Elev. of Main at tap _____
Gate at ● Gate at ●

● Curb Box