


Labor and Materials

1	Copper	Connection	3	\$	96
1	Curb	Cock Valve	1	\$	133
	Service Box	Sheet 4 1/2 x 5 1/2	1	\$	135
	Old returned	Bottom of Valve			
12	Ft.	Copper Pipe at	7	\$	180
	Nipples	in. at	4	\$	
	Bushings	to in. at		\$	
	Red'g Inc'g	Couplings to in. at		\$	
	Union	in. at		\$	
	Meter	in. at		\$	
	Lbs. Br. Stone	at		\$	
	Lbs. Sand	at		\$	
	Bags Cement	at		\$	
	Paving Brick	Mack Red Asphalt at		\$	
	Lead Joints	at		\$	
	Leadite Joints	at		\$	
	Hrs. Foreman	at		\$	
	Hrs. Common Labor	at		\$	
	Hrs. Mason	at		\$	
	Hrs. Masons Helper	at		\$	
	Hrs. Compressor	at		\$	
	Compensation Ins			\$	
	Trucking			\$	
	Builders Use of Water	Patch		\$	5.00
				Total \$	

Labor and Material Report


17 Aug 13 1936
17 Ogden St

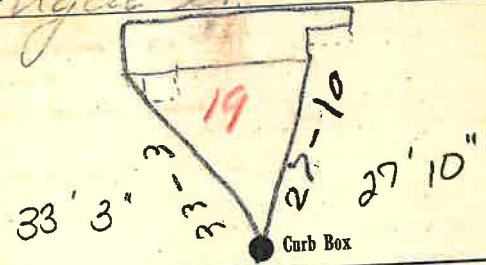

TAX ID # 302.16-5-22

4 Main

Elev of Main at tap 5 1/2

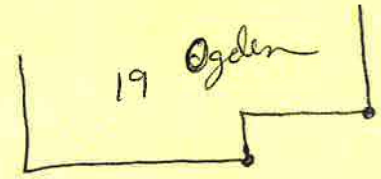

26' 10" 40'

• Buffalo Box
line dead?

found Aug. 2000