

## LABOR AND MATERIALS

|    |                             |   |                                      |            |         |
|----|-----------------------------|---|--------------------------------------|------------|---------|
| 1  | Copper<br>Lead              | } Connection                                      | 3/4                                  | \$ 1.35    |         |
| 1  | Curb                        | { Cock<br>Valve<br>T.S. & V. }                    | 3/4 in.                              | \$ 1.80    |         |
| 1  | Service Box<br>Old returned | { Short 3/4x4/4<br>Long 4/4x5/4<br>Buffer Rdway } |                                      | \$ 1.70    |         |
| 14 | Ft.                         | 3/4 in.   | { Copper<br>Galv Iron<br>Cast Iron } | Pipe at 18 | \$ 2.52 |
|    | Nipples                     | in. at  |                                      | \$         |         |
|    | Bushings                    | to in. at   |                                      | \$         |         |
|    | Red'g<br>Inc'g              | } Couplings                                       | to in. at                            | \$         |         |
|    | Union                       | in. at  |                                      | \$         |         |
|    | Meter                       | in. at  |                                      | \$         |         |
|    | Lead Joints at              |   |                                      | \$         |         |
|    | Leadite Joints at           |   |                                      | \$         |         |
|    | Hrs. Foreman at             |   |                                      | \$         |         |
| 1  | Hrs. Chauffeur at           | 62 1/2  |                                      | \$ 63      |         |
| 2  | Hrs. Tapper at              | 4   |                                      | \$ 1.75    |         |
| 10 | Hrs. Labor at               | 45  |                                      | \$ 4.50    |         |
|    | Hrs. Labor at               |   |                                      | \$         |         |
|    | Hrs. Compressor at          |   |                                      | \$         |         |
|    | Compensation Ins.           |   |                                      | \$ 20      |         |
|    | Trucking                    |   |                                      | \$ 1.00    |         |
|    | Builders Use of Water       | By the Party                                      |                                      | \$         |         |
|    | Tally Hessel                |   |                                      | \$         |         |
|    |                             |   |                                      | \$         |         |
|    |                             |   |                                      | \$         |         |
|    |                             |   |                                      | \$         |         |
|    |                             |   |                                      | \$         |         |
|    |                             |   |                                      | \$ 1.495   |         |


59 1941

St. 23  
Pl.  
Ave. No. 23

Name of Owner

Labor and Mat'l. Report

1941

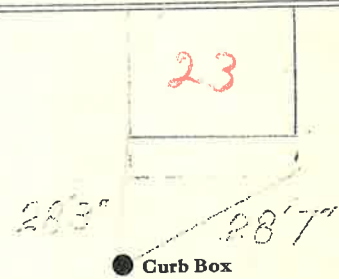

4 Main Elev. of Main at tap 5  
Gate at ● Gate at ●

● Curb Box

Tax ID # 302.16-5-20