


Labor and Materials

Copper	Connection	?	\$ 2.60
Lead			
Curb	Cock Valve F. S. & V.	in.	\$ 2.27
Service Box	Short 3/2x4 1/2		\$ 1.59
Old returned	Long 4 1/2x5 1/2		
	Buff or Rdwty		
24 Ft.	Copper Galv. Iron Pipe at		\$ 4.32
	Cast Iron		
	Nipples	in. at	\$
	Bushings	to in. at	\$
	Red'g Inc'g Couplings	to in. at	\$
	Union	in. at	\$
	Meter	in. at	\$
	Lbs. Br. Stone at		\$
	Lbs. Sand at		\$
	Bags Cement at		\$
	Paving Brick	Mack Red Asphalt at	\$
	Lead Joints at		\$
	Leadite Joints at		\$
5	Hrs. Foreman at		\$ 3.13
71	Hrs. Common Labor at		\$ 9.45
	Hrs. Common Labor at		\$
	Hrs. Mason at		\$
	Hrs. Mason's Helper at		\$
	Hrs. Compressor at		\$
	Compensation Ins		\$ 39
	Trucking		\$ 1.00
	Builders' Use of Water	Patch	\$ 5.00
Total \$			29.75

32-1 6
Labor and Material Report

1931

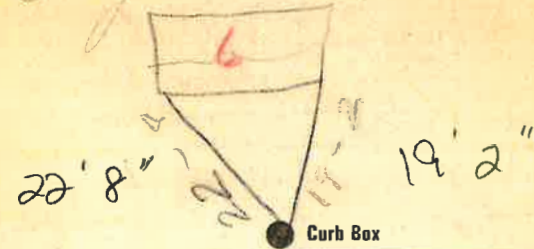

Main

Elev of Main at tap

Gate at ●

● Gate at

● Curb Box

TAX ID # 302.16-4-2