

Labor and Materials


Copper } Connection.....	\$ 2.60
Lead }	
Curb } Cock }	\$ 2.30
} Valve }	
} T. S. & V. }	
Service Box } Short 3 1/2 x 4 1/2 }	\$ 1.40
Old returned } Long 4 1/2 x 5 1/2 }	
} Bull. or Rdway }	
12 Ft. in. } Copper } Pipe at.....	\$ 3.18
} Galv. Iron }	
} Cast Iron }	
Nipples..... in. at.....	\$
Bushings..... to..... in. at.....	\$
Red'g } Couplings..... to..... in. at.....	\$
Inc'g }	
Union..... in. at.....	\$
Meter..... in. at.....	\$
Lbs. Br. Stone at.....	\$
Lbs. Sand at.....	\$
Bags Cement at.....	\$
Paving Brick } Mack } at.....	\$
} Red }	
} Asphalt }	
Lead Joints at.....	\$
Leadite Joints at.....	\$
2 Hrs. Foreman at.....	\$ 1.25
10 Hrs. Common Labor at.....	\$ 4.06
Hrs. Common Labor at.....	\$
Hrs. Mason at.....	\$
Hrs. Mason's Helper at.....	\$
Hrs. Compressor at.....	\$
Compensation Ins.....	\$.17
Trucking.....	\$ 1.00
Builders' Use of Water Patch.....	\$ 5.00
Total \$ 20.93	

29-189 31

Labor and Material Report

19

29 29-189-31

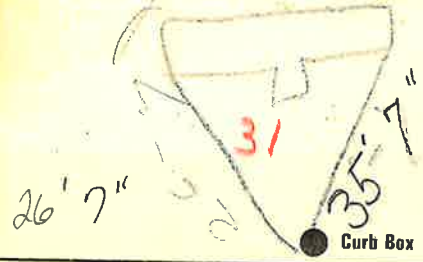

4 Main Elev of Main at tap

Gate at ● ● Gate at

● Curb Box

Yew house

Tax ID# 302.16-5-16