

LABOR AND MATERIALS

Copper	Connection	\$	
Lead			
1 Curb	Cock Valve F.S. & V. } in.	\$	3.79
1 Service box	Short 3 1/2 x 4 1/2		
Old returned	Long 4 1/2 x 5 1/2	\$	4.71
	Buff or Rdway		
55 Ft. 3/4 in.	Copper G.I. } Pipe at	\$	18.62
7	C.I.		
1 Nipples 3/4 in.	at	\$.13
	Bushings to in.	at	\$
	Red'g Coupl'gs to in.	at	\$
	Inc'g		
1 Union 3/4 in.	at	\$	48
1 Meter 3/4 in.	at	\$	30
	Lead Joints at	\$	
1 Compound Joints at 3/4	at	\$	60
6 Hrs. Water Maint. Man-1	at	\$	7.62
8 Hrs. Water Maint. Man-2	at	\$	6.96
6 Hrs. Labor	at	\$	6.18
	Hrs. Labor at	\$	
2 Hrs. Compressor at 1.25		\$	2.50
	Compensation Ins. at \$ per C.	\$	
	Trucking	\$	
	Pav't Patch	\$	
1-Curb pack 3/4 old		\$	
		\$	
		\$	
	O'head	\$	

this tap is connected \$ 51.89
 to service pipe at 360
 Ogden St

15-1950


Ogden

St. ~~Pr~~
 Ave. No. 38

Name of Owner

G. & B. Hardware Co. Office Building

Labor and Mat'l. Report Jan 18 1950

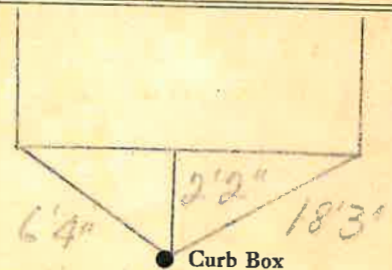

3/4 Main Elev. of Main at tap 4 1/2

Gate at • Gate at

TAX ID # 302.12-17-1

• Curb Box