

## LABOR AND MATERIALS

1	Copper Lead	} Connection $\frac{3}{4}$	\$ 1.35	
1	Curb	} Cock Valve T. S. & V. $\frac{3}{4}$ in.	\$ 1.80	
1	Service Box Old returned	} Short $3\frac{1}{2} \times 4\frac{1}{2}$ Long $4\frac{1}{2} \times 5\frac{1}{2}$ Buff or Rdway	\$ 1.70	
14	Ft. $\frac{3}{4}$ in.	} Copper Galv. Iron Cast Iron	Pipe at 18 \$ 2.52	
	Nipples	in. at	\$	
	Bushings	to in. at	\$	
	Red'g Inc'g	} Couplings to in. at	\$	
	Union	in. at	\$	
	Meter	in. at	\$	
	Lead Joints	at	\$	
	Leadite Joints	at	\$	
	Hrs. Foreman	at	\$	
1	Hrs. Chauffeur	at $6\frac{1}{2}$	\$ 6.25	
2	Hrs. Tapper	at $4$	\$ 1.25	
10	Hrs. Labor	at $45$	\$ 4.50	
	Hrs. Labor	at	\$	
	Hrs. Compressor	at	\$	
	Compensation Ins.		\$	
	Trucking		\$ 20	
	Builders Use of Water	Before Paving	\$	
	Tap by Hassel		\$	
			\$	
			\$	
			\$ 14.95	

5 2 1941

St. 7  
Pl. # 17  
Ave. No. \_\_\_\_\_


Name of Owner \_\_\_\_\_

*Wm Hackett*

Labor and Mat'l. Report

*May 19*

19 *41*

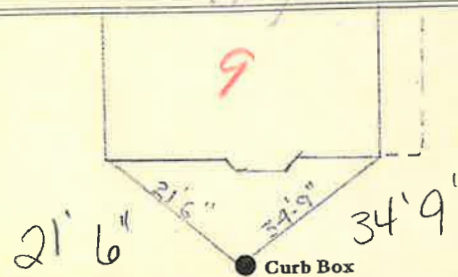

Main

Elev. of  
Main at tap *5*

Gate at ●

● Gate at

● Curb Box

TAX ID # 302.16-5-27