


Labor and Materials

1	Copper } Connection $\frac{3}{4}$	\$ 3.20
1	Lead } Connection $\frac{3}{4}$	\$ 1.00
1	Curb { Cock Valve } $\frac{3}{4}$ in.	\$ 1.30
	{ T. S. & V. }	
1	Service Box { Short $3\frac{1}{2} \times 4\frac{1}{2}$ } Old returned { Long $4\frac{1}{2} \times 5\frac{1}{2}$ } { Buff. or Rdway }	\$ 5.72
26	Ft. $\frac{3}{4}$ in. { Copper Galv. Iron } Pipe at	\$
	{ Cast Iron }	\$
	Nipples..... in. at.....	\$
	Bushings..... to..... in. at.....	\$
	Red'g } Couplings..... to..... in. at.....	\$
	Inc'g }	\$
	Union..... in. at.....	\$
	Meter..... in. at.....	\$
	Lbs. Br. Stone at.....	\$
	Lbs. Sand at.....	\$
	Bags Cement at.....	\$
	Paving Brick { Mack } at.....	\$
	{ Red }	\$
	{ Asphalt }	\$
	Lead Joints at.....	\$
	Leadite Joints at.....	\$
2	Hrs. Foreman at.....	\$ 1.25
7	Hrs. Common Labor at..... J. D.	\$ 3.50
7	Hrs. Common Labor at..... A. J. G.	\$ 2.84
	Hrs. Mason at.....	\$
	Hrs. Mason's Helper at.....	\$
	Hrs. Compressor at.....	\$
	Compensation Ins.....	\$.20
	Trucking.....	\$ 1.00
	Builders' Use of Water.....	\$
Total		\$ 20.01

27-197 10
Labor and Material Report Oct 27 1927

* 8 Adgen St

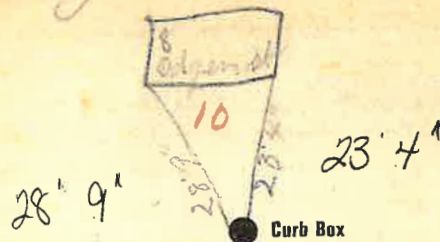

4" Main

Elev. of Main at tap 442

Gate at ●

● Gate at

● Curb Box

Old shut off

TAX ID # 302.16-4-4