


Labor and Materials

1	Lead Connection	3	\$
1	Curb Cock	3	\$
1	Service Box (Short 3 1/4 x 4 1/2)		\$
1	Old returned (Buffalo 4 1/2 x 6)		\$
11	3/4 in. G. I. Pipe at		\$
	Nipples in. at		\$
1	Bushings 1/2 to 5/8 in. at		\$
	Red'g Coup. to in. at		\$
	Inc'g Coup. to in. at		\$
	Union in. at		\$
	Meter in. at		\$
	Cu. Yds. Br. Stone at		\$
	Cu. Yds. Sand at		\$
	Bags Cement at		\$
	Paving Brick (Mack Red Asphalt) at		\$
1	Hrs. Foreman at		\$
7	Hrs. Common Labor at		\$
1	Hrs. Mason at		\$
1	Hrs. at		\$
	Hrs. at		\$
No	Builders' Use of Water		\$
	Truck		\$ 1.00
	at		\$
	at		\$
	at		\$
	at		\$
	Total		\$

11 Edgemoor St

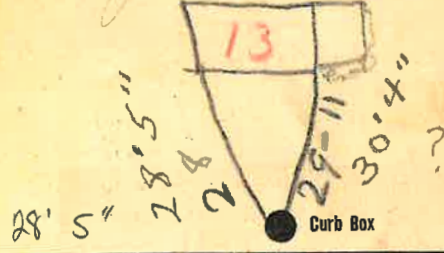

4 Main Elev. of Main at tap 4 1/2
Gate at Gate at



TAX ID # 302.16-5-25