

LABOR AND MATERIALS

3/4" ~~Copper~~ Connection _____ \$ _____
 Lead }
 Curb } Cock Valve } _____ in. _____ \$ _____
 T.S. & V. }
 Service box { Short 3-1/2 x 4-1/2 } _____ \$ _____
 Old returned { Long 4-1/2 x 5-1/2 } _____ \$ _____
 49 Ft. 6 in. ~~Copper~~ Pipe at _____ \$ _____
 C.I. }
 Nipples _____ in. at _____ \$ _____
 Bushings _____ to _____ in. at _____ \$ _____
 Red'g _____
 Inc'g _____
 Union _____ in. at _____ \$ _____
 Meter _____ in. at _____ \$ _____
 _____ \$ _____
 Compound Joints at _____ \$ _____
 Maintenance Foreman _____ \$ _____
 Hrs. Water Maint. Man - 1 at _____ \$ _____
 Hrs. Water Maint. Man - 2 at _____ \$ _____
 Hrs. Garage Foreman _____ at _____ \$ _____
 Hrs. Labor _____ at _____ \$ _____
 Hrs. Compressor at _____ \$ _____
 _____ \$ _____
 Trucking _____ \$ _____
 Pav't Patch _____ \$ _____
 _____ \$ _____
 _____ \$ _____
 _____ \$ _____
 _____ \$ _____


QB 4

4 old Forge

St. Ave. No. 4

Name of Owner _____

Labor and Mat'l. Report ~~18~~ 9/12/14

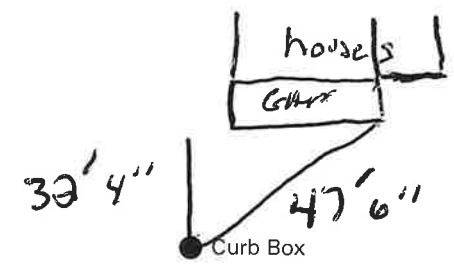

6" Main

AC Elev. of Main at tap 6'

Gate at ● Gate at ●

TAX ID # 302.13-1-19

3/4" Two (Lines) (TAPS)

● Curb Box