


LABOR AND MATERIALS

1	Copper Lead	} 3/4" male Adapter COP. TO IR.	\$ 73
1	Curb Valve T.S. & V.		\$ 383
1	Service box Old returned	{ Short 3 1/2 x 4 1/2 Long 4 1/2 x 5 1/2 Buff or Rdway	\$ 4.69
12	Ft. 3/4 in.	{ Copper C.I. C.I.	Pipe at 45 \$ 5.40
	Nipples	in. at	\$
1	Bushings	2" to 3/4 in. at	\$ 53
	Red'g Inc'g	Coupl'gs to in. at	\$
	Union	in. at	\$
	Meter	in. at	\$
	Lead Joints	at	\$
	Compound Joints	at	\$
1	Maintenance Foreman		\$ 1.51
	Hrs. Water Maint. Man—1	at	\$
	Hrs. Water Maint. Man—2	at	\$
	Hrs. Garage Foreman	at	\$
	Hrs. Labor—	at	\$
	Hrs. Compressor	at	\$
	Compensation Ins.	at \$ 4.29 per C	\$ 06
	Trucking		\$ 1.50
	Pay't Patch		\$
	Tap by Miller	6-30-55	\$
	O'head		\$
			\$ 18.25

Lot-11

St. _____
Pl. _____
Ave. No. 10
Name of Owner Old Forge Rd. off Dixon Rd.
Hanza

Labor and Mat'l. Report June 30 1955

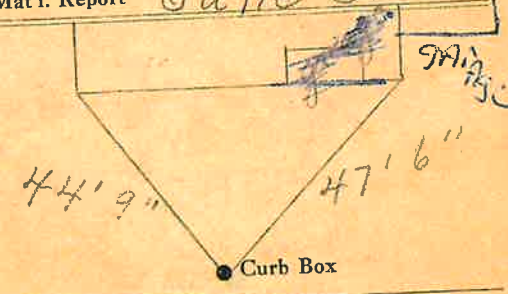

Galv. 2" Main
Elev. of Main at tap 5'

Gate at • Gate at •

TAX ID # 302.13-1-35

• Curb Box