

LABOR AND MATERIALS


1	Copper Lead	3/4" Male Adapter	\$ 73
1	Curb	Cock Valve T.S. & V. } 3/4" in. Cop. to 11"	\$ 3.83
1	Service box Old returned	{ Short 3 1/2 x 4 1/2 Long 4 1/2 x 5 1/2 Buff or Rdway }	\$ 4.64
14	Ft. 3/4 in.	{ Copper G.I. C.I. } Pipe at 45	\$ 6.30
	Nipples	in. at	\$
1	Bushings	2" to 3/4 in. at	\$.53
	Red'g Inc'g	Coupl'gs to in. at	\$
	Union	in. at	\$
	Meter	in. at	\$
	Lead Joints at		\$
	Compound Joints at		\$
1	Maintenance Foreman		\$ 1.51
	Hrs. Water Maint. Man-1 at		\$
	Hrs. Water Maint. Man-2 at		\$
	Hrs. Garage Foreman at		\$
	Hrs. Labor at		\$
	Hrs. Compressor at		\$
	Compensation Ins. at \$ 4.29 per C		\$.06
	Trucking		\$ 1.50
	Pay't Patch		\$
	Tap by Miller	6-30-55	\$
	O'head		\$
			\$ 19.15

Lot-12

St. _____
Pl. _____
Ave. No. 12
Old Forge Rd.
Name of Owner 055 Dixon Rd.

Price

Labor and Mat'l. Report June 30 1956

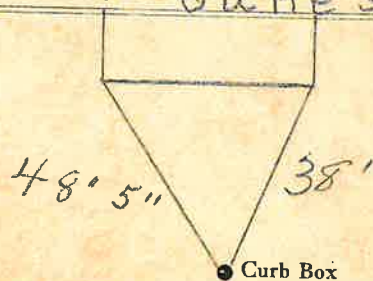

galv.
2" Main

Elev. of Main at tap 5'

Gate at • • Gate at

TAX ID # 302.17-4-1

• Curb Box