


LABOR AND MATERIALS

1	Copper Lead	3/4" Male Adapter Connection cop. to 11.	\$ 73
1	Curb	Cock Valve T.S. & V. } 3/4 in.	\$ 383
1	Service box	Short 3 1/2 x 4 1/2	\$ 4.69
	Old returned	Long 4 1/2 x 5 1/2	
		Buff or Rdway	
12	Ft. 3/4 in.	Copper G.I. } Pipe at 45	\$ 540
	Nipples	in. at	\$
1	Bushings	2" to 3/4 in. at	\$ 53
	Red'g Inc'g	Coupl'gs to in. at	\$
	Union	in. at	\$
	Meter	in. at	\$
	Lead Joints	at	\$
	Compound Joints	at	\$
1	Maintenance Foreman		\$ 151
	Hrs. Water Maint. Man-1	at	\$
	Hrs. Water Maint. Man-2	at	\$
	Hrs. Garage Foreman	at	\$
	Hrs. Labor	at	\$
	Hrs. Compressor	at	\$
	Compensation Ins.	at \$ 4.29 per C	\$ 06
	Trucking		\$ 150
	Pav't Patch	outside	\$
	Tap by Miller	6-30-55	\$
	O'head		\$
			\$ 18.25

Lot-13

St. Old Forge Rd. Pl. 14 Ave. No. 14
 Name of Owner off Dixon Rd.
 Hart

Labor and Mat'l. Report June 30 19 55

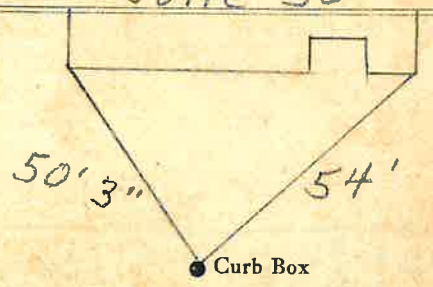

2" Galv. Main Elev. of Main at tap 5'
 Gate at • Gate at •

TAX ID # 302.17-4-2

• Curb Box