


LABOR AND MATERIALS

1 Copper ^{3/4" Male Adapter} Connection \$ 73
 1 Lead }
 1 Curb { Cock } 3/4 in. \$ 3.83
 { Valve }
 { T.S. & V. }
 1 Service box { Short 3 1/2 x 4 1/2 }
 Old returned { Long 4 1/2 x 5 1/2 } \$ 4.69
 { Buff. or Rdway }
 60 3/4 in. { Copper } Pipe at 45 \$ 27.00
 { C.I. }
 { C.I. }
 Nipples in. at \$
 Bushings to in. at \$
 Red'g }
 Inc'g } Coupl'gs to in. at \$
 Union in. at \$
 Meter in. at \$
 Lead Joints at \$
 Compound Joints at \$
 Maintenance Foreman \$
 Hrs. Water Maint. Man-1 at \$
 Hrs. Water Maint. Man-2 at \$
 Hrs. Garage Foreman at 1.59 \$ 17.1
 Hrs. Labor at 1.13 \$ 33.9
 Hrs. Compressor at \$
 Compensation Ins. at \$ 1.24 per C. \$ 3.5
 Trucking \$ 1.50
 Pay't Patch \$
 Top by Haregu \$
 Wadleigh 9-9-55 \$
 O'head \$
 \$46.26
 Bill 135 ft @ 17.50
 28.76

Lot-16

St.
 Pl.
 Ave. No. 20
 Old Forge Rd.
 Name of Owner 075 Dixon Rd
 Axtell

Labor and Mat'l. Report Sept. 9 19 55

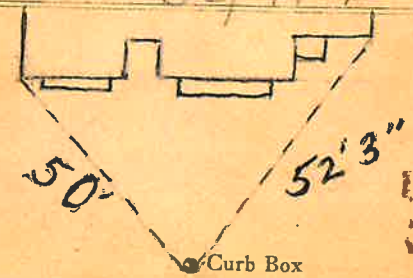

2" galv. Main Elev. of Main at tap 4 1/2'
 Gate at • Gate at
 TAX ID# 302.17-4-5

Note: Use Yellow Tee Wrench
 • Curb Box