

LABOR AND MATERIALS

1	Copper } Connection			\$ 1.31
	Lead }			
1	Curb { Cock Valve } $\frac{3}{4}$ in.			\$ 1.75
		F.S. & V. }		
1	Service Box } Short $3\frac{1}{2} \times 4\frac{1}{2}$			\$ 1.60
	Old returned } Long $4\frac{1}{2} \times 5\frac{1}{2}$			
		Buffer Rdway }		
9	Ft. $\frac{3}{4}$ in. } Copper } Pipe at 18			\$ 1.62
		Galv Iron }		
		Cast Iron }		
	Nipples..... in. at			\$
	Bushings..... to..... in. at			\$
	Red'g } Couplings..... to..... in. at			\$
	Inc'g }			
	Union..... in. at			\$
	Meter..... in. at			\$
	Lead Joints at			\$
	Leadite Joints at			\$
	Hrs. Foreman at			\$
1/2	Hrs. Chauffeur at	62 1/2		\$ 31
1/4	Hrs. Tapper at			\$ 16
53 1/4	Hrs. Labor at	45		\$ 2.59
	Hrs. Labor at			\$
	Hrs. Compressor at			\$
	Compensation Ins.			\$ 1.10
	Trucking			\$ 1.00
	Builders Use of Water			\$
				\$
				\$
	Tap by Penor			\$
				\$ 10.44

133 - 1940


St.
Pt.
Ave. No. 17

Oneida

Name of Owner

Ball, Robt.

Labor and Mat'l. Report NOV 7 - 1940 19

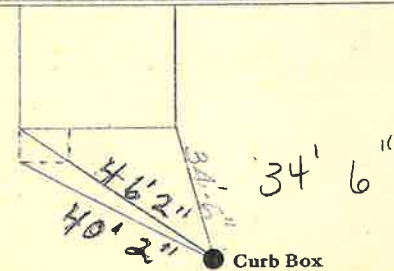

6" Main

Elev. of Main at top 5'

Gate at ●

● Gate at

TAX ID# 303.13-15-9

● Curb Box

tr