

LABOR AND MATERIALS


Copper	} Connection	_____	\$ _____	
Lead				
Curb	} Cock Valve } T. S. & V. }	_____ in.	\$ _____	
Service box		} Short 3 1/2 x 4 1/2 } Long 4 1/2 x 5 1/2 }	_____	
Old returned			Buff or Rdway	\$ _____
Ft. _____ in.	} Copper } G. I. } C. I. }	Pipe at _____	\$ _____	
Nipples _____ in.		at _____	\$ _____	
Bushings _____ to _____ in.		at _____	\$ _____	
Red'g } Inc'g }	} Coupl'gs _____ to _____ in.	at _____	\$ _____	
Union _____ in.		at _____	\$ _____	
Meter _____ in.	at _____	\$ _____		
Lead Joints at _____		\$ _____		
Compound Joints at _____		\$ _____		
Maintenance Foreman _____		\$ _____		
Hrs. Water Maint. Man—1 at _____		\$ _____		
Hrs. Water Maint. Man—2 at _____		\$ _____		
Hrs. Garage Foreman _____ at _____		\$ _____		
Hrs. Labor _____ at _____		\$ _____		
Hrs. Compressor at _____		\$ _____		
Compensation Ins. at \$ _____ per C		\$ _____		
Trucking _____		\$ _____		
Pav't Patch _____		\$ _____		
_____		\$ _____		
_____		\$ _____		
_____		\$ _____		
O'head _____		\$ _____		
_____		\$ _____		

St. Pl. Ave. No. 25

ONIERA
Name of Owner

John Caporal

Labor and Mat'l. Report Nov. 14 1982

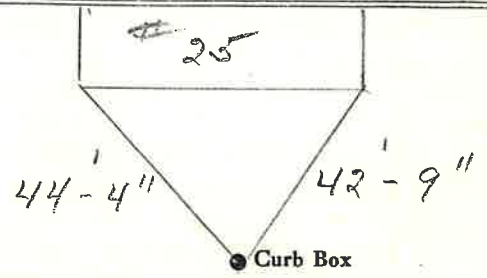

_____ Main Elev. of Main at tap _____

Gate at • Gate at

TAX ID # 303.13-15-5

NEW HOUSE • Curb Box
1\"/>