

LABOR AND MATERIALS

1	Copper	Connection	3/4"	\$
	Lead			
1	Curb	Cock Valve T.S. & V.	3/4 in.	\$
1	Service box	Short 3 1/2 x 4 1/2 Long 4 1/2 x 5 1/2 Buff or Rdway		\$
	Old returned			
25	3/4 in.	Copper G.I. G.I.	Pipe at	\$
	Nipples	in. at		\$
	Bushings	to in. at		\$
	Red'g	Coupl'gs	to in. at	\$
	Inc'g			
	Union	in. at		\$
	Meter	in. at		\$
	Lead Joints	at		\$
	Compound Joints	at		\$
	Maintenance Foreman			\$
	Hrs. Water Maint. Man-1	at		\$
	Hrs. Water Maint. Man-2	at		\$
	Hrs. Garage Foreman	at		\$
	Hrs. Labor	at		\$
	Hrs. Compressor	at		\$
	Compensation Ins. at \$	per C		\$
	Trucking			\$
	Pav't Patch			\$
	Top by Miller & Co.			\$
	15-15-57			\$
	O'head			\$
				\$


Oneida

St.
 -Pl-
 Ave. No. 26

Name of Owner

Pattoe

Labor and Mat'l. Report May 15 19 57

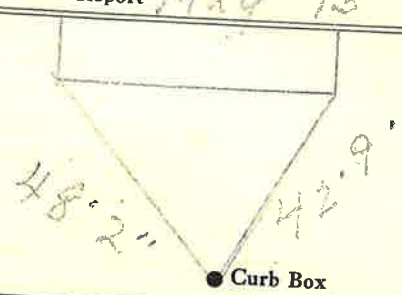

6" Main

Elev. of Main at tap 4'

Gate at • Gate at

TAX ID# 303.13-13-10

• Curb Box