


Labor and Materials

| | | | | |
|----------|------------------------|---|------------------|-----------------|
| 1 | Copper | } Connection ^{3/4"} | | \$ |
| | Lead | | | |
| 1 | Curb | } Cock Valve T.S.&V. ^{3/4"} | | \$ |
| | | | | |
| 1 | Service Box | } Short 3 1/2 x 4 1/2 Long 4 1/2 x 5 1/2 | | \$ |
| | Old returned | | Buff. or Railway | |
| 1.2 | Ft. ^{3/4"} in | } Copper Galv. Iron Cast Iron | Pipe at | |
| | | | | |
| | Nipples | | in. at | |
| | Bushings | | to in. at | |
| | Red'g Inc'g | } Couplings | | to in. at |
| | | | | |
| | Union | | in. at | |
| | Meter | | in. at | |
| | Lbs. Br. Stone | at | | \$ |
| | Lbs. Sand | at | | \$ |
| | Bags Cement | at | | \$ |
| | Paving Brick | } Mack Red Asphalt | at | |
| | Lead Joints | | | at |
| | Leadite Joints | at | | \$ |
| | Hrs. Foreman | at | | \$ |
| | Hrs. Common Labor | at | | \$ |
| | Hrs. Common Labor | at | | \$ |
| | Hrs. Mason | at | | \$ |
| | Hrs. Masons Helper | at | | \$ |
| | Hrs. Compressor | at | | \$ |
| | Compensation Ins | | | \$ |
| | Trucking | | | \$ |
| | Builders Use of Water | | | \$ |
| Total \$ | | | | |

Labor and Material Report *Sept 27* 19*35*

3/4" tap at 7 Oneida St.

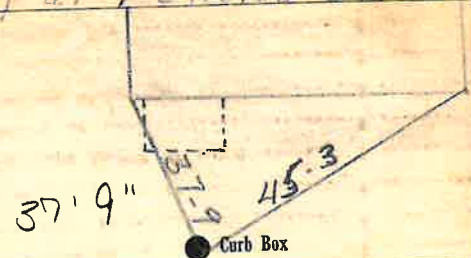

4" Main

Elev of Main at tap *5'*

Gate at ●

● Gate at

● Curb Box

Tax 10th 303.13-14-3