


LABOR AND MATERIALS

1	Copper Lead	Connection	3/4"	\$
1	Curb	Cook Valve T.S. & V.	3/4 in. Oriseal	\$
1	Service box	Short 3 1/2 x 4 1/2		
	Old returned	Long 4 1/2 x 5 1/2		
		Buff or Rdway		\$
16	Ft. 3/4 in.	Copper Pipe at		\$
		G.I.		
		C.I.		
	Nipples	in. at		\$
	Bushings	to in. at		\$
	Red'g			
	Inc'g	Coupl'gs to in. at		\$
	Union	in. at		\$
	Meter	in. at		\$
	Lead Joints	at		\$
	Compound Joints	at		\$
	Maintenance Foreman			\$
	Hrs. Water Maint. Man-1	at		\$
	Hrs. Water Maint. Man-2	at		\$
	Hrs. Garage Foreman	at		\$
	Hrs. Labor	at		\$
	Hrs. Compressor	at		\$
	Compensation Ins. at \$	per C		\$
	Trucking			\$
	Pav't Patch			\$
	Tap by Gifford & Co			\$
				\$
				\$
	O'head			\$
				\$

St. Oneida  
 Pl. 33  
 Ave. No. 33

Name of Owner McPerrin

Labor and Mat'l. Report April 15 1965

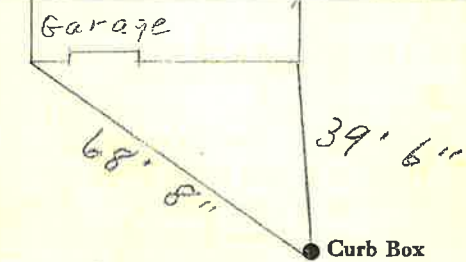

5" C.I. Main Elev. of Main at tap 5'

Gate at • Gate at •

TAX ID # 303-13-15-3

● Curb Box