


LABOR AND MATERIALS

1 Copper } Connection <sup>3/4"</sup> \$ \_\_\_\_\_  
 Lead }  
 1 Curb } Cock } 3/4 in. \$ \_\_\_\_\_  
 Valve }  
 T.S. & V. }  
 1 Service box } { Short 3 1/2 x 4 1/2 }  
 Old returned } { Long 4 1/2 x 5 1/2 } \$ \_\_\_\_\_  
 } { Buff or Rdway }  
 39 Ft. <sup>3/4</sup> in. } { Copper } Pipe at \$ \_\_\_\_\_  
 } { G.I. }  
 } { C.I. }  
 Nipples in. at \$ \_\_\_\_\_  
 Bushings to in. at \$ \_\_\_\_\_  
 Red'g }  
 Inc'g } Coupl'gs to in. at \$ \_\_\_\_\_  
 Union in. at \$ \_\_\_\_\_  
 Meter in. at \$ \_\_\_\_\_  
 Lead Joints at \$ \_\_\_\_\_  
 Compound Joints at \$ \_\_\_\_\_  
 Maintenance Foreman \$ \_\_\_\_\_  
 Hrs. Water Maint. Man—1 at \$ \_\_\_\_\_  
 Hrs. Water Maint. Man—2 at \$ \_\_\_\_\_  
 Hrs. Garage Foreman at \$ \_\_\_\_\_  
 Hrs. Labor— at \$ \_\_\_\_\_  
 Hrs. Compressor at \$ \_\_\_\_\_  
 Compensation Ins. at \$ \_\_\_\_\_ per C. \$ \_\_\_\_\_  
 Trucking \$ \_\_\_\_\_  
 Pav't Patch \$ \_\_\_\_\_  
 Tap by *G. J. ...* \$ \_\_\_\_\_  
 Co. # *4-52-59* \$ \_\_\_\_\_  
 O'head \$ \_\_\_\_\_  
 \$ \_\_\_\_\_

St. <sup>34</sup>  
 Pl. <sup>32</sup>  
 Ave. No. <sup>32</sup>  
 Name of Owner *P. K. ...*

Labor and Mat'l. Report *April 22* 19 *59*

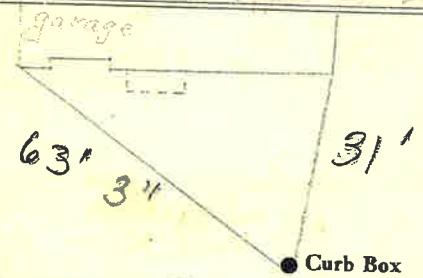

6" Main Elev. of Main at tap *14 1/2'*

Gate at • Gate at  
 TAX ID # *303.13-13-12*

• Curb Box