

Labor and Materials

Copper	} Connection.....	3	\$	1.23
Lead				
Curb	} Cock Valve } F-S-R-V.	in 1	\$	1.68
Service Box				
Old removed	} Short 3 1/2 x 4 1/2 } Long 4 1/2 x 5 1/2 } Buff. or Rdway		\$	1.75
9 Ft. 3/4 in.				
	} Copper } Galv. Iron } Cast Iron }	Pipe at .15	\$	1.35
Nipples				
Bushings	to	in. at	\$	
Red'g	} Conplings.....	to	in. at	\$
Inc'g				
Union	in. at	\$		
Meter	in. at	\$		
Lead Joints	at	\$		
Leadite Joints	at	\$		
Hrs. Foreman	at	\$		
3 Hrs. Chauffeur	at 6 1/2	\$	1.88	
Hrs. Tapper	at	\$		
4 Hrs. Labor	at 4 1/2	\$	1.80	
Hrs. Labor	at	\$		
Hrs. Compressor	at	\$		
Compensation Ins.		\$.12	
Trucking		\$	1.00	
Builders Use of Water		\$		
Tap by Person		\$		
1/2 of Patch (sewer)		\$	2.50	
		\$		
		\$	13.31	


23 - 1938

St. Pt. Ave. No. 9

Draida

Name of Owner Stewart

Labor and Mat'l. Report 5-23-38 19

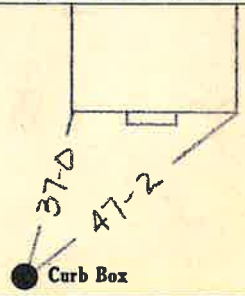

● Curb Box

6 Main

Elev. of Main at tap 5

Gate at ●

● Gate at

● Curb Box

New house.
TAX ID # 303.13-14-2

#