


Labor and Materials

Copper } Connection.....	\$3.20
Lead }	
Curb } Cock Valve }	\$1.00
} T. S. & V. }	
Service Box } Short 3/4 x 4 }	\$1.20
Old returned } Long 2 x 5 }	
} Buff. or midway }	
13 Ft. 3/4 in. } Copper } Pipe at.....	\$2.86
} Galv. Iron }	
} Cast Iron }	
Nipples..... in. at.....	\$
Bushings..... to..... in. at.....	\$
1 Red'g } Couplings. Ball to..... in. at.....	\$.15
Inc'g }	
Union..... in. at.....	\$
Meter..... in. at.....	\$
Lbs. Br. Stone at.....	\$
Lbs. Sand at.....	\$
Bags Cement at.....	\$
Paving Brick } Mack } at.....	\$
} Red }	
} Asphalt }	
Lead Joints at.....	\$
Leadite Joints at.....	\$
3 Hrs. Foreman at..... 6.25	\$1.88
2 Hrs. Common Labor at..... 50	\$1.00
Hrs. Common Labor at.....	\$
Hrs. Mason at.....	\$
Hrs. Mason's Helper at.....	\$
Hrs. Compressor at.....	\$
Compensation Ins.....	\$.02
Trucking.....	\$1.00
Builders' Use of Water.....	\$
Total \$12.98	

11 Oneida
corner of Oneida and Oneida St

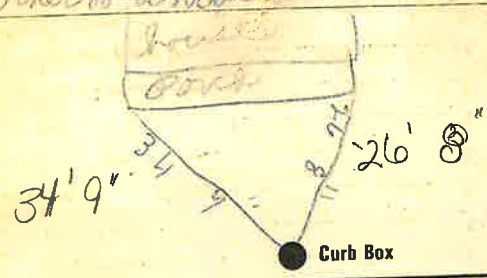

1/2" Main Elev. of Main at tap 4'
Gate at ● TAX ID # 303.13-14-1 ● Gate at

● Curb Box
new tap
new house.
Tap ON ONEIDA ST

LABOR AND MATERIALS

1	Copper Lead	Connection	3/4		\$ 2.80
1	Curb	Clock Valve T.S. & V.	3/4 in.		\$ 3.00
1	Service box	Old returned } Short 3 1/2 X 4 1/2 Long 4 1/2 X 5 1/2 Buff or Rdway }			\$ 5.80
12	Ft.		Copper Galv. Iron Cast Iron	3/4 in.	Pipe at 35
		Nipples	in.	at	\$
		Bushings	to	in. at	\$
		Red'g Inc'g	Couplings	to in. at	\$
		Union	in.	at	\$
		Meter	in.	at	\$
		Lead Joints	at		\$
		Compound Joints	at		\$
5	Hrs.	Foreman at			\$ 4.55
	Hrs.	Chauffeur at	91		\$
	Hrs.	Tapper at			\$
6	Hrs.	Labor at	80		\$ 4.80
	Hrs.	Labor at			\$
	Hrs.	Compressor at			\$
		Compensation Ins.			\$ 21
		Trucking			\$ 5.80
		Builders Use of Water.			\$
		Tap by Naisville			\$
					\$
					\$
					\$
					\$ 32.76

111-47


Oneida

St. Rear
Pl.
Ave. No. 11

Name of Owner

Antonsen

Labor and Mat'l. Report May 19 1947

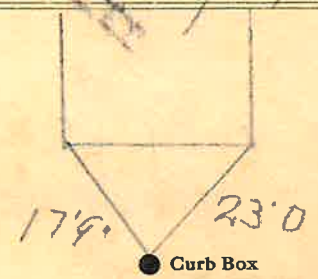

6 Main

Elev. of Main at tap. 4

Gate at ●

● Gate at

● Curb Box

Rear #11 Oneida St.

Tap on Union St.

This tap on Union St.